


T. 18S. R. 3W.W.M.

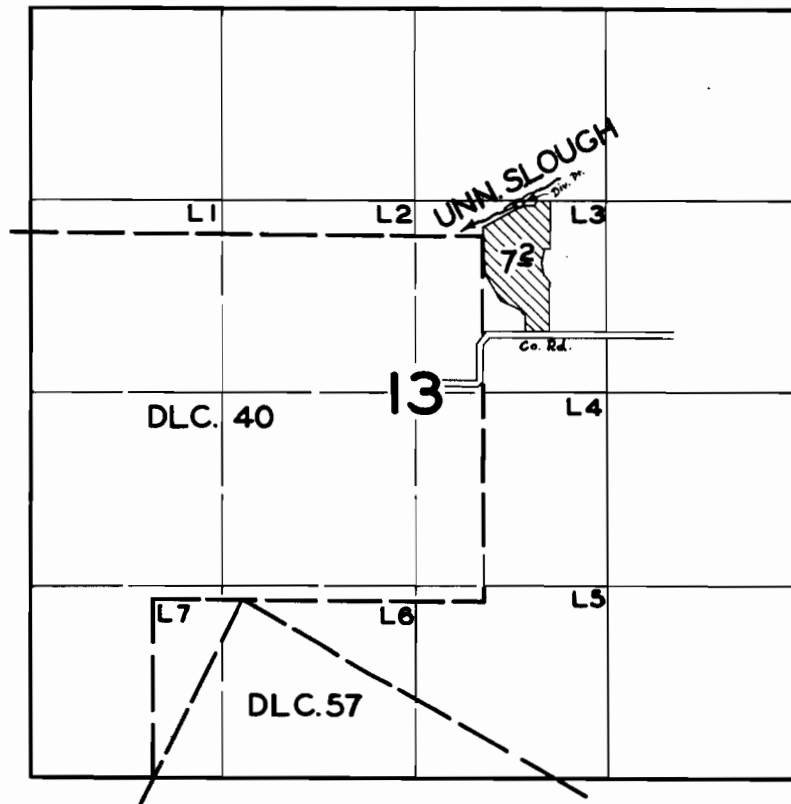

FINAL PROOF SURVEY
UNDER

Application No. 31999 Permit No. 25246
IN NAME OF

FLOYD A. MCBEE

Surveyed MAR. 26 1959, by M. BISH