


T. 19S. R. 1W&IE. W.M. :

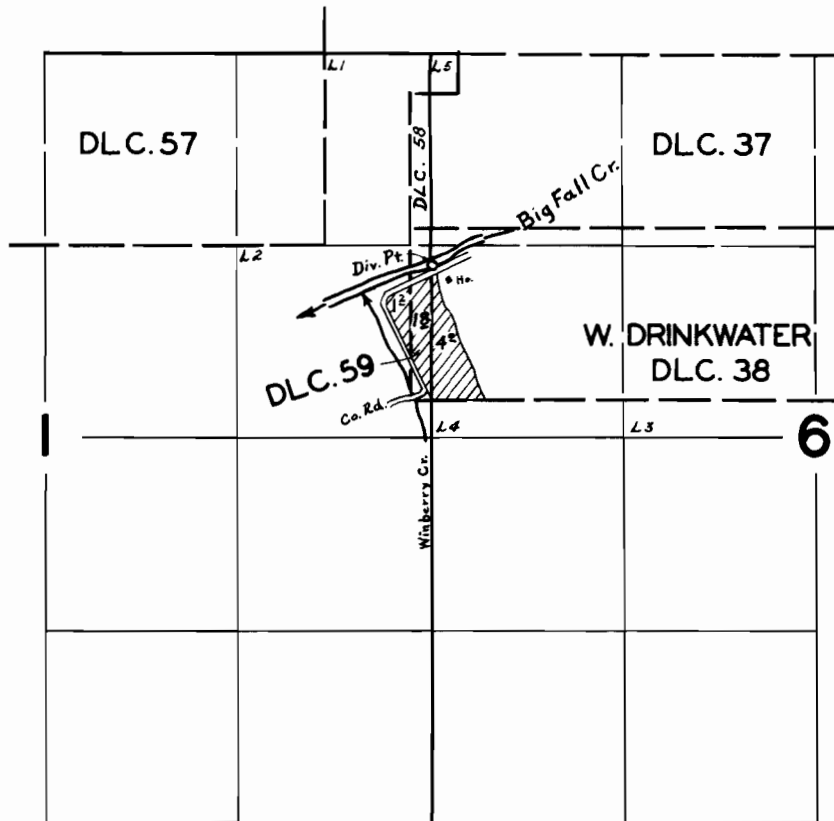

FINAL PROOF SURVEY
UNDER

Application No. 32096 Permit No. 25330
IN NAME OF

E. F. EDWARDS

Surveyed APR. 2 1959, by M. BISH