


T. 13S. R. 10W. W.M.

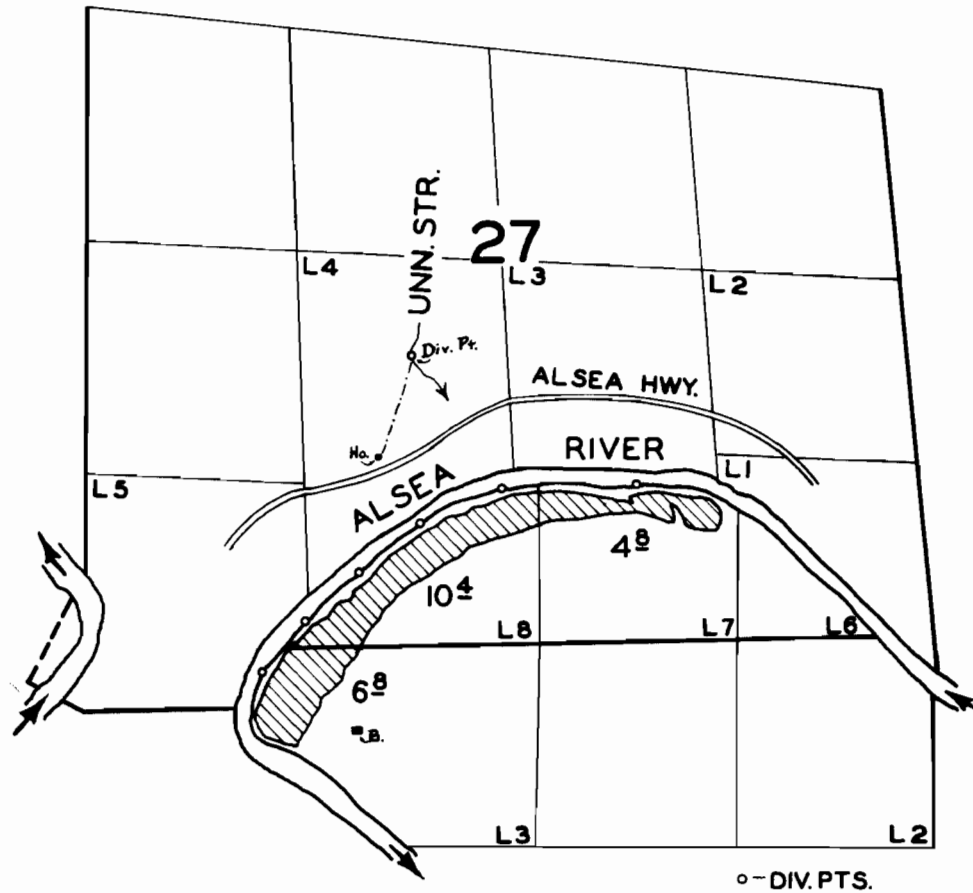

FINAL PROOF SURVEY
UNDER

28062 22073
Application No. 30789 Permit No. 24243
IN NAME OF

FRANCIS L. BARCLAY

Surveyed APR. 9 1959, by M. BISH