


T. 14S. R. 11W. W.M.

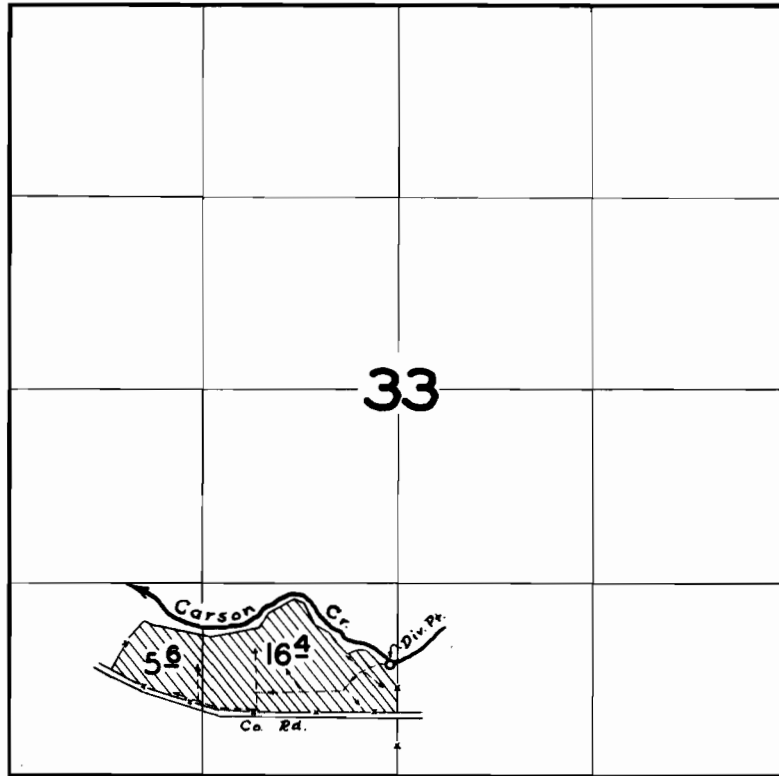

FINAL PROOF SURVEY
UNDER

Application No. 28417 Permit No. 23262
IN NAME OF

LESTER HALL

Surveyed APR. 7, 1959, by M. BISH