


26122

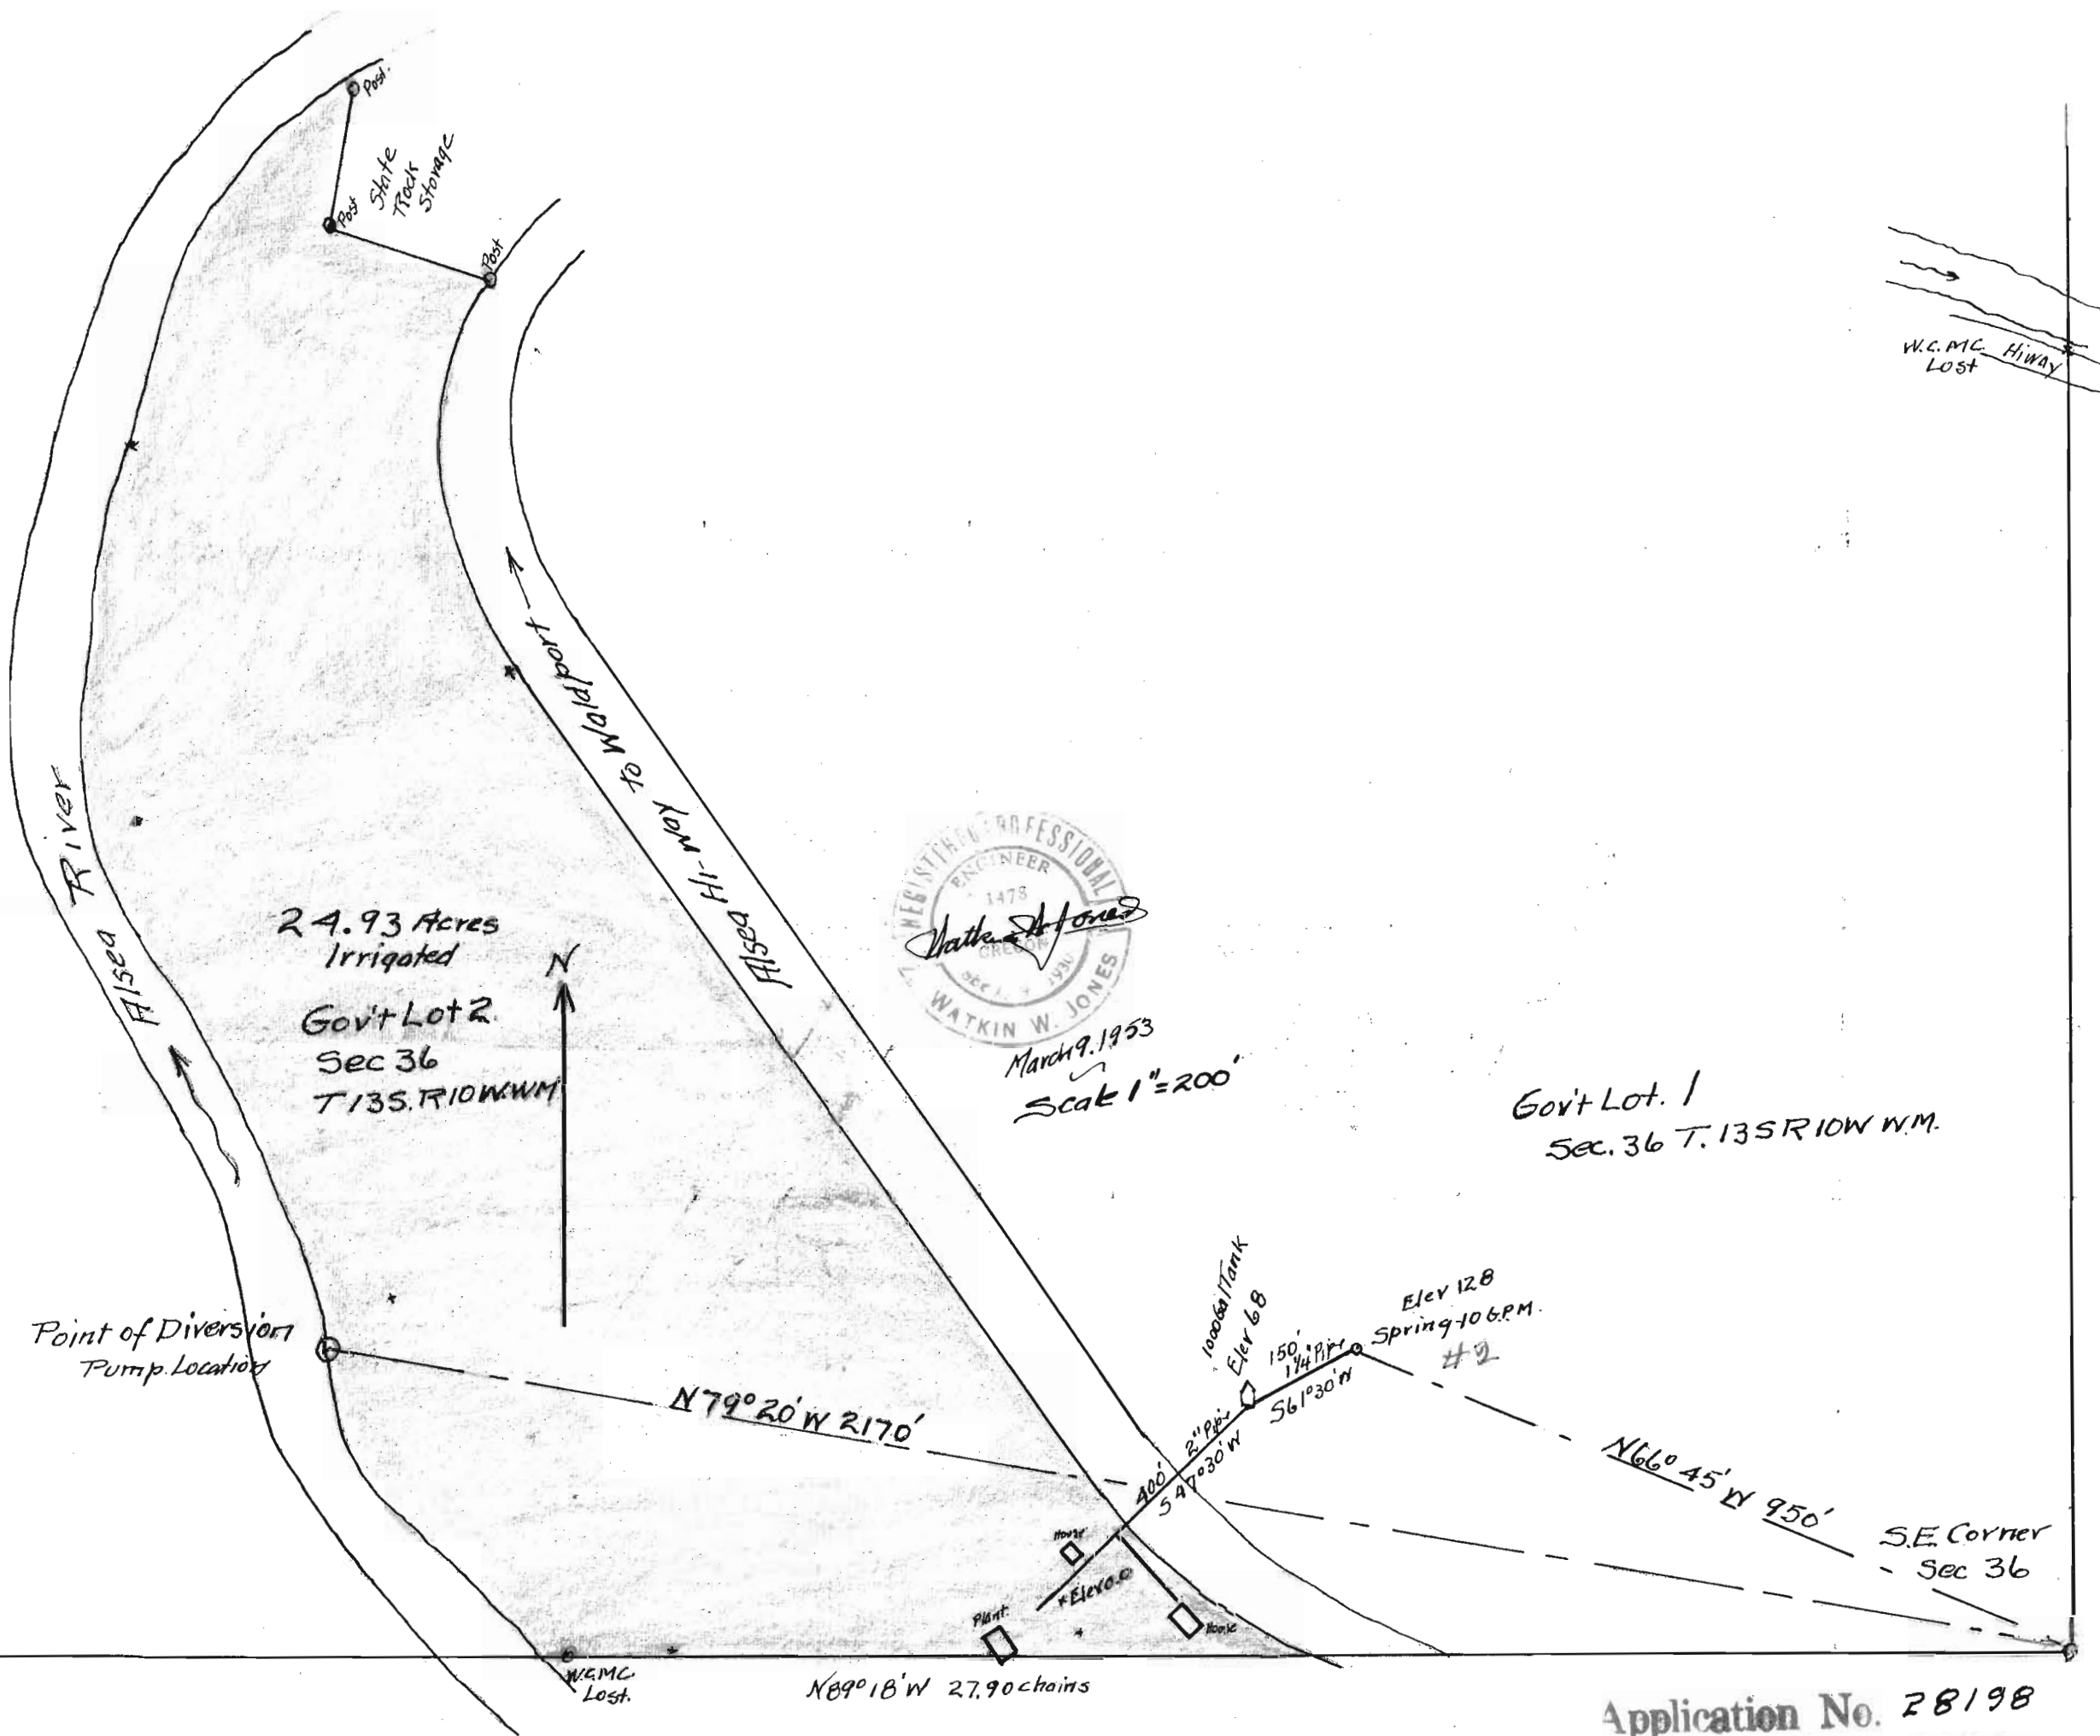

Application No. 28198
 Permit No. 23917