


T. 12S. R. 1W.W.M.

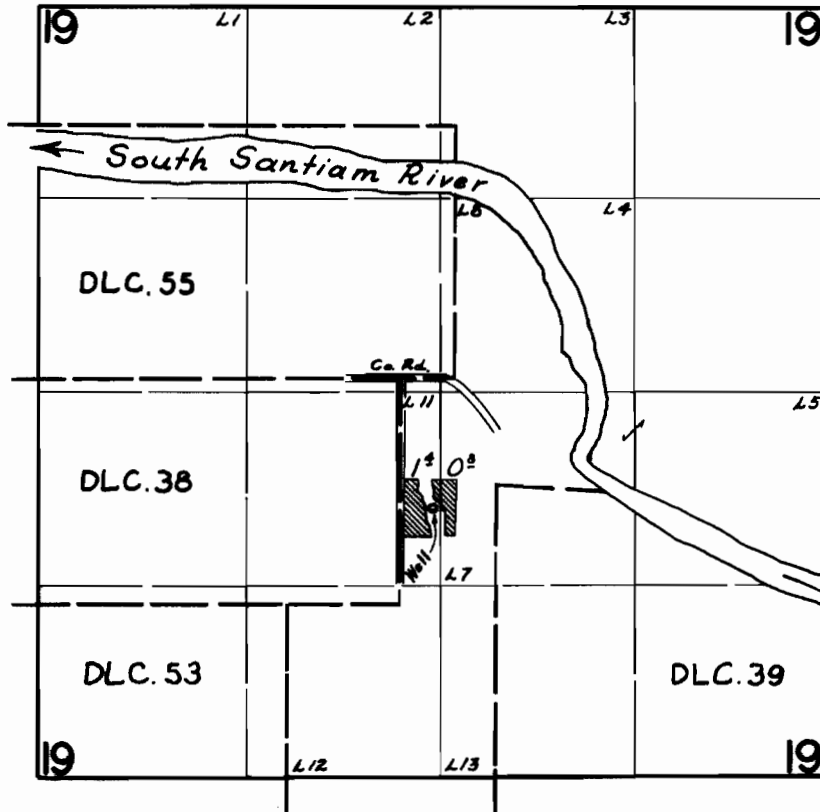

FINAL PROOF SURVEY

UNDER

Application No. G-463 Permit No. G-336

IN NAME OF

Albert G. & Anna P. Bazant

Surveyed Aug. 27, 1959, by C. O. Bartels