


T. 14S. R. 4W. W.M.

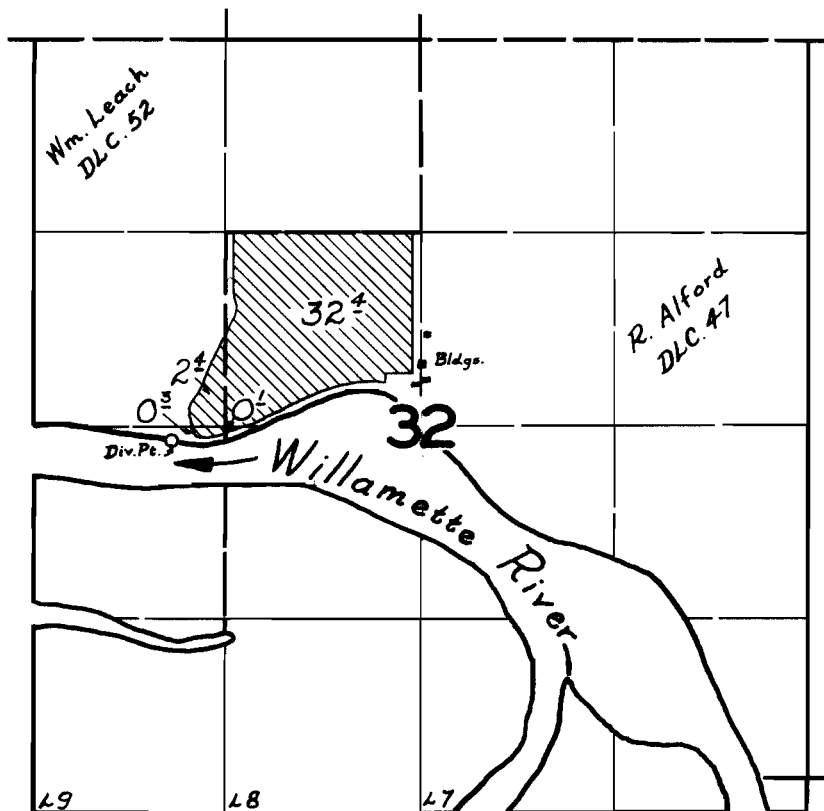

FINAL PROOF SURVEY

UNDER

Application No. 28165 Permit No. 22165

IN NAME OF

Carl & Alice Sandell

Surveyed Sept. 2 1959, by C. O. Bartels