


T. 15S. R. 4W.W.M.

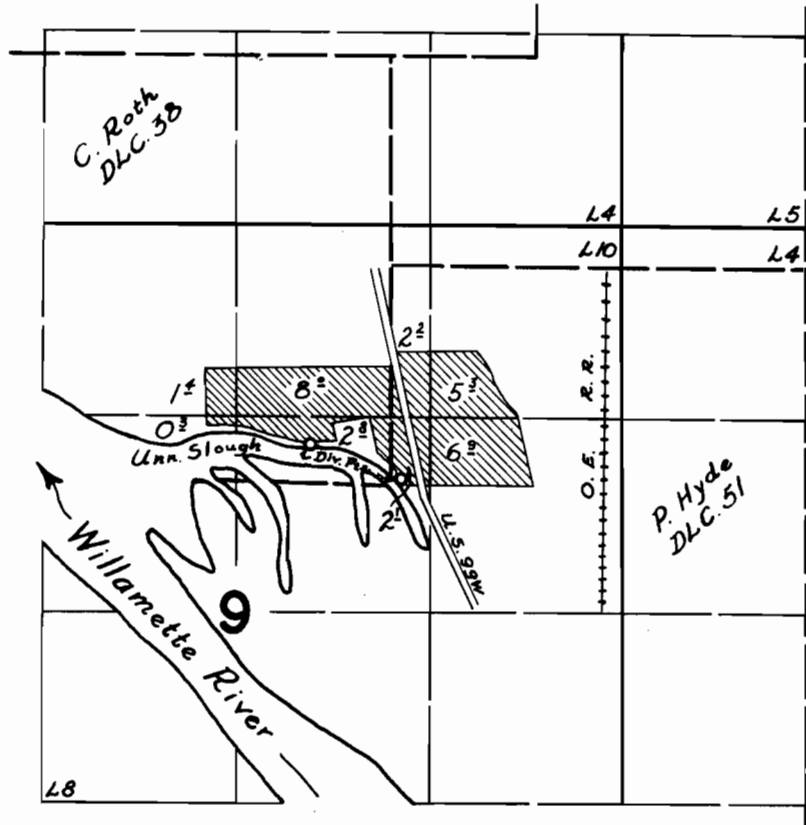

FINAL PROOF SURVEY

UNDER

Application No. 28348 Permit No. 22372

IN NAME OF

Lester F. Coate

Surveyed Sept. 2, 1959, by C. O. Bartels