


T. 10S. R. 3W. W.M.

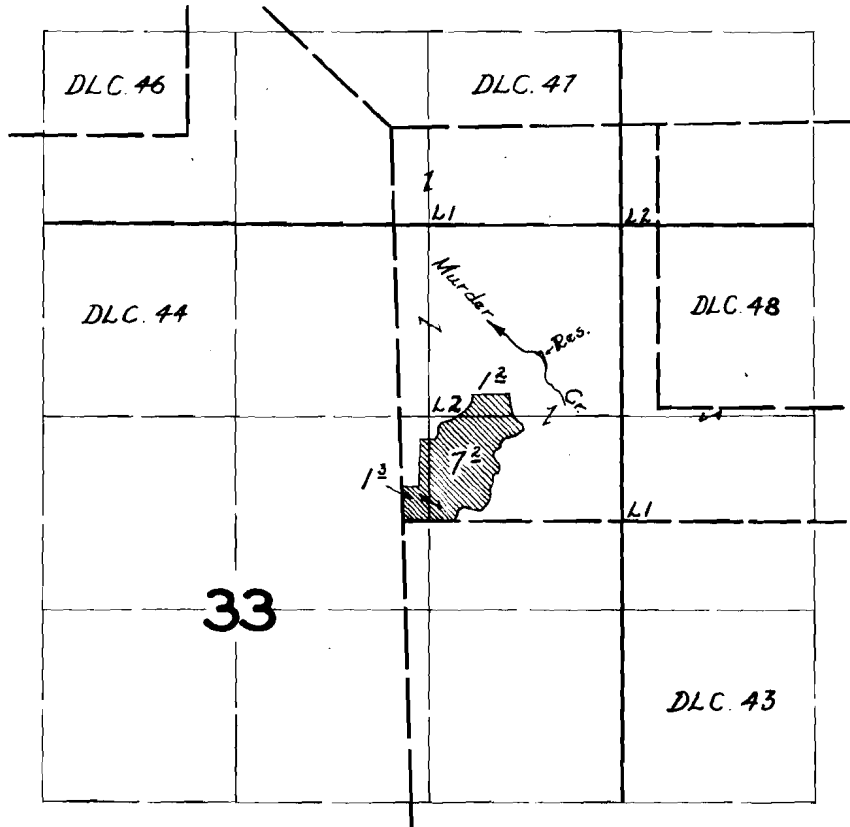

FINAL PLAT SURVEY

R-31059

R-1924

31060

24459

Ivan M. & Doris Gainer

Surveyed July 31, 1959

G.O. Bartels