


T. 12S. R. 1W. W.M.

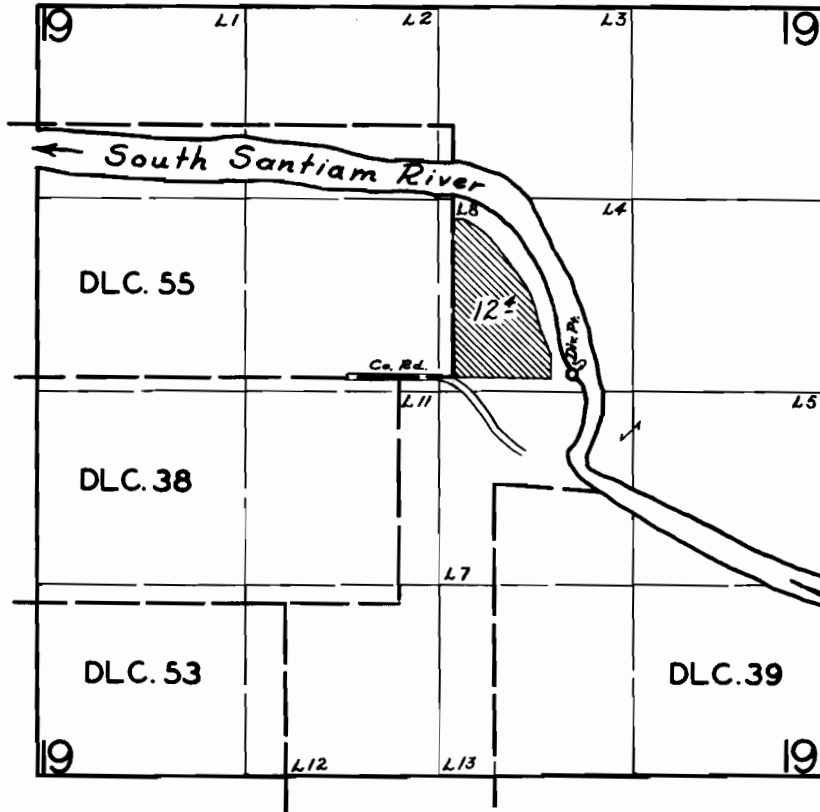

FINAL PROOF SURVEY

UNDER

Application No. 31821 Permit No. 25097

IN NAME OF

HOWARD E. HICKCOX

Surveyed AUG. 27 1959, by C.O. BARTELS