


T. 22 S. R. 46 & 47 E. W.M

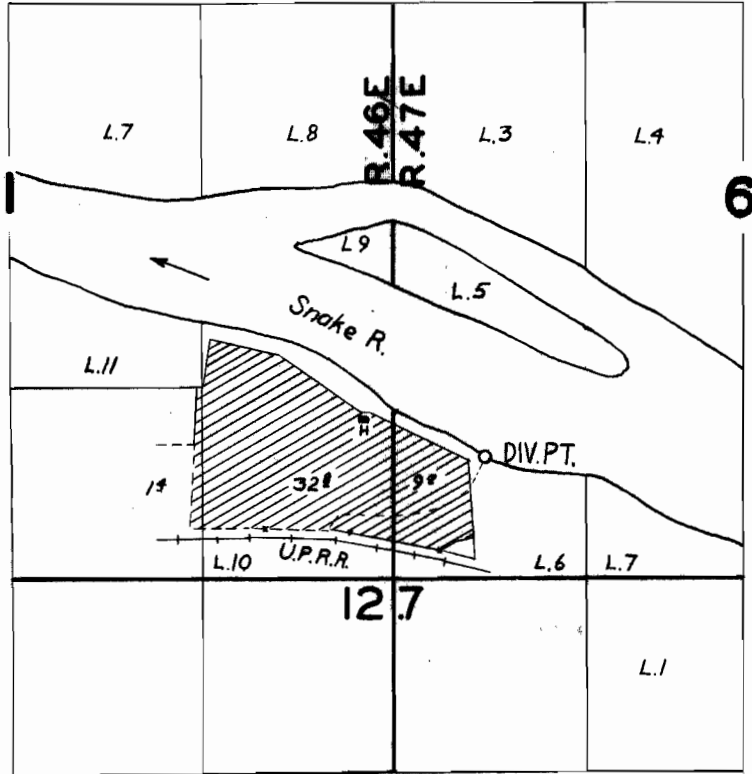

FINAL PROOF SURVEY UNDER

Application No. 20718 Permit No. 16213

IN NAME OF

Fay M & Betty Jo Metzger

Surveyed July 14 1953, by F. L. Hoffman