


T.24 & 25 S.R.39 E.W.M.

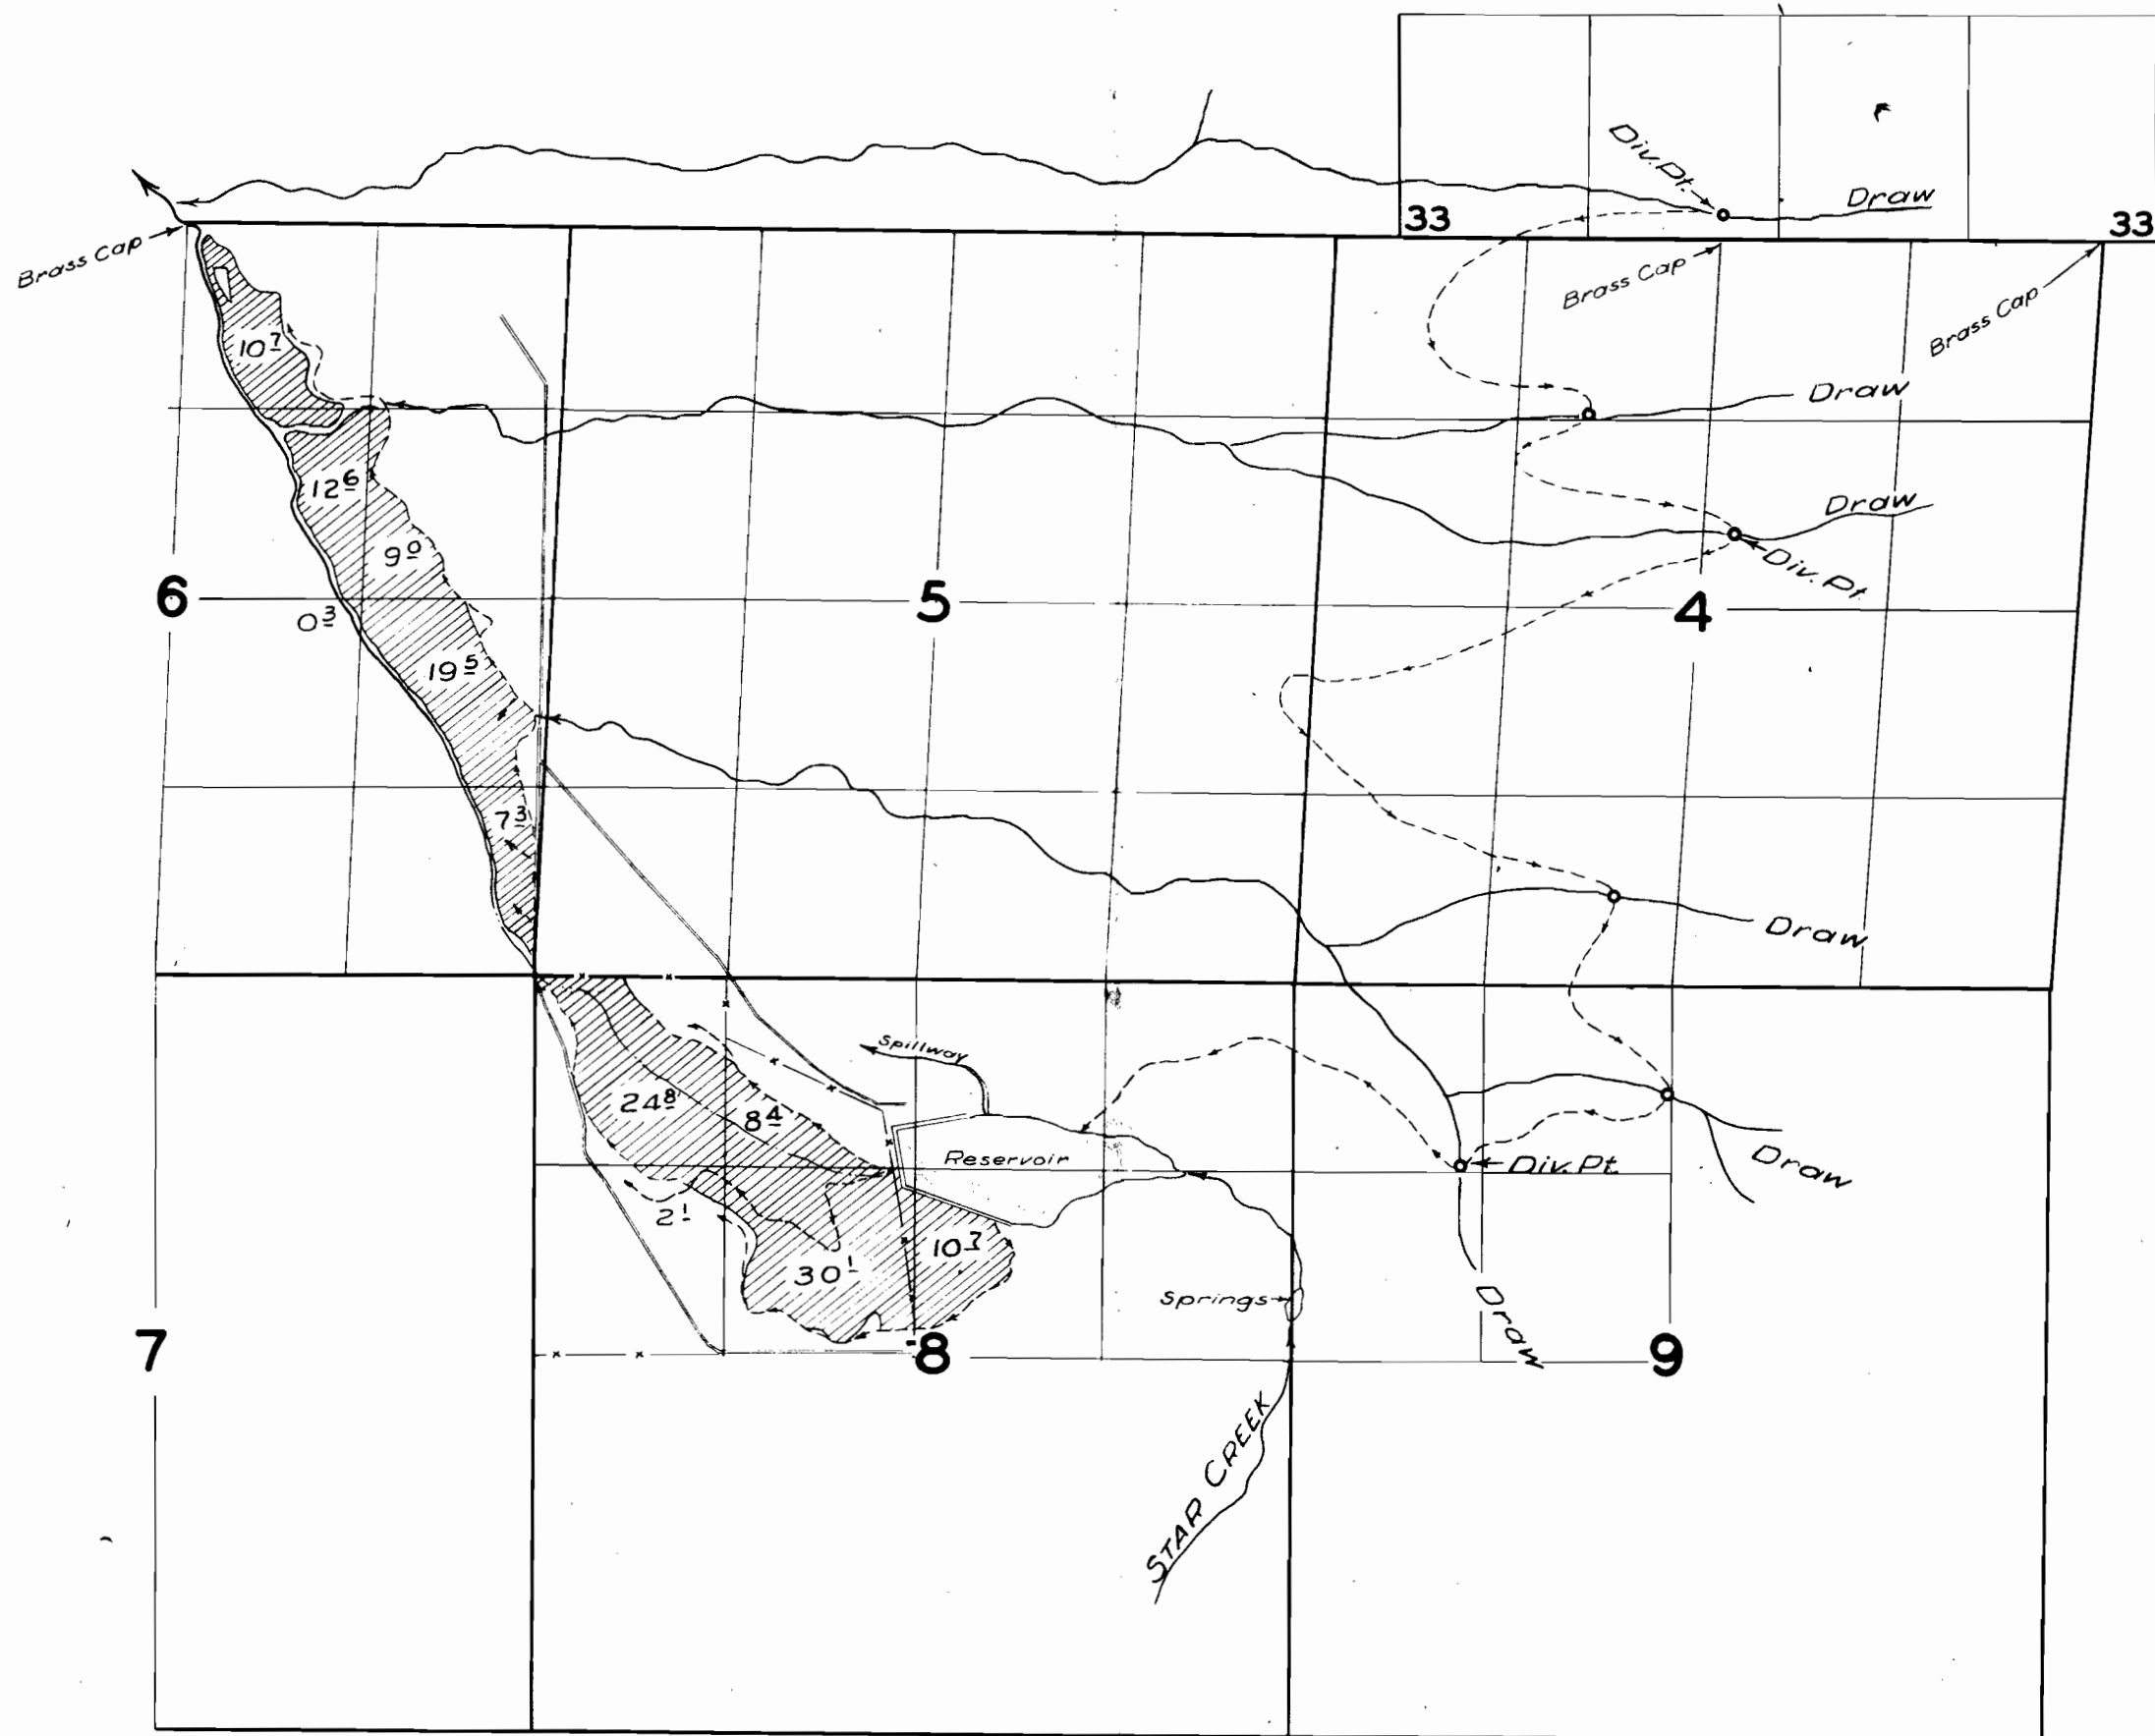

FINAL PROOF SURVEY

24245
R-24244
26432
R-26431

19087
R-998
20128
R-1253

CHAS. W. CHAPMAN

Surveyed 28 Sept. 59. by M. B. Rich