


T. 4 S. R. 1 W. W.M.

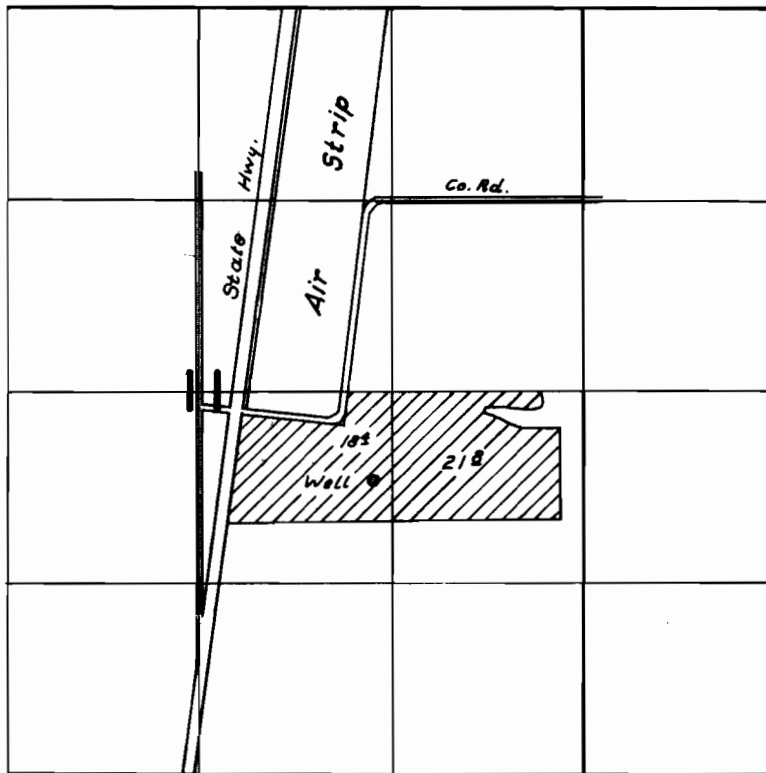

FINAL PROOF SURVEY
UNDER

Application No. *G338* Permit No. *G222*
IN NAME OF

George H. Wiederhold

Surveyed *April 22 1959*, by *R. H. Jackson*