


T. 6S. R. 2W. W.M.

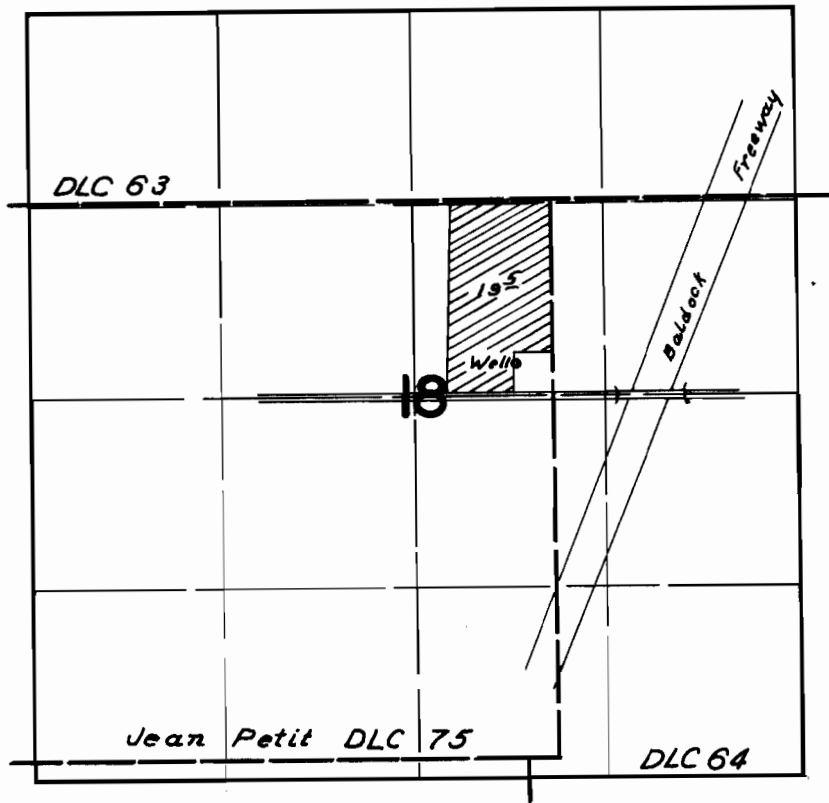

FINAL PROOF SURVEY
UNDER

Application No. *G377* Permit No. *G253*
IN NAME OF

E. A. Hillyer

Surveyed *May 26 1959*, by *C. O. Bartels*