


T. 6S. R. 2W. W.M.

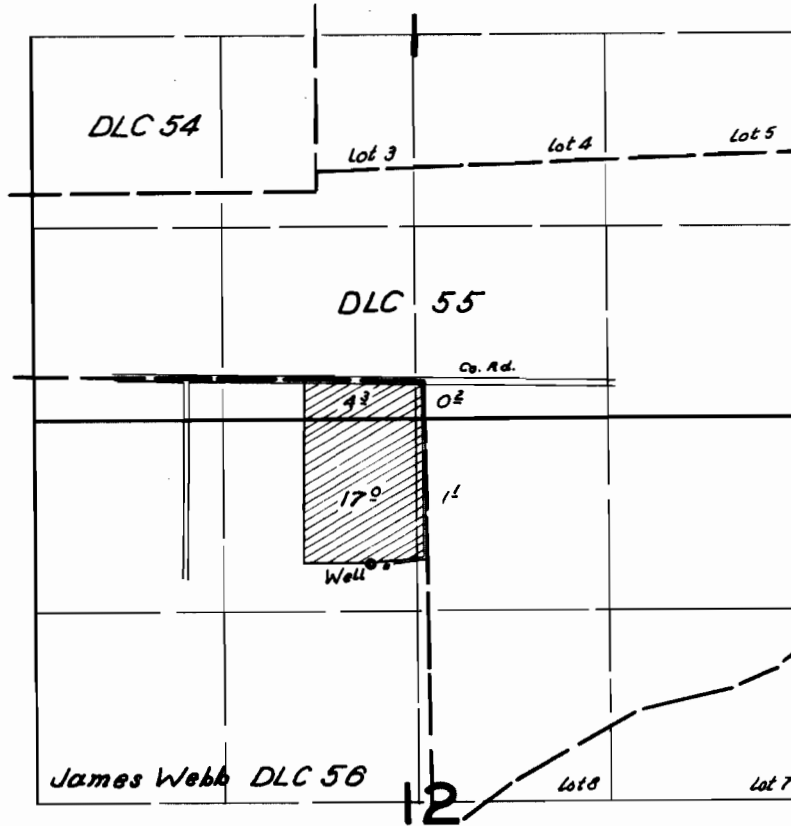

FINAL PROOF SURVEY
UNDER

Application No. *G382*..... Permit No. *G257*.....
IN NAME OF

.....*Edward Peter Schlechter*.....

Surveyed *May 29 1959*, by *C.O. Bartels*.....