


T. 6S. R. 3W. W.M.

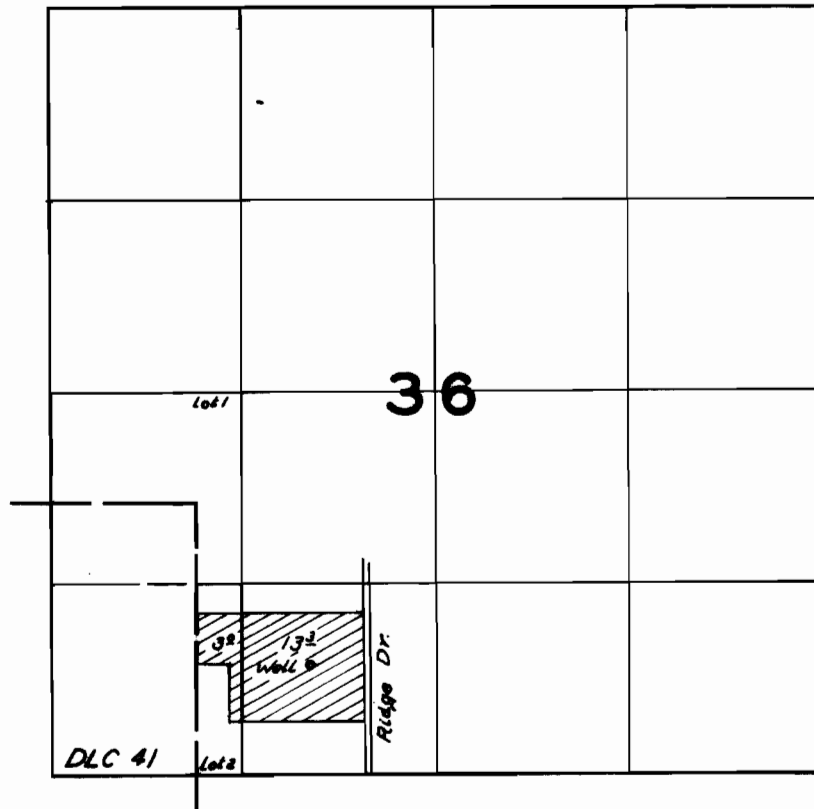

**FINAL PROOF SURVEY**  
UNDER

Application No. *G464* ..... Permit No. *G337* .....  
IN NAME OF

..... *Robert F. Austin* .....

Surveyed *May 26 1959*, by *C.O. Bartels* .....