


T. 7S. R. 2W.W.M.

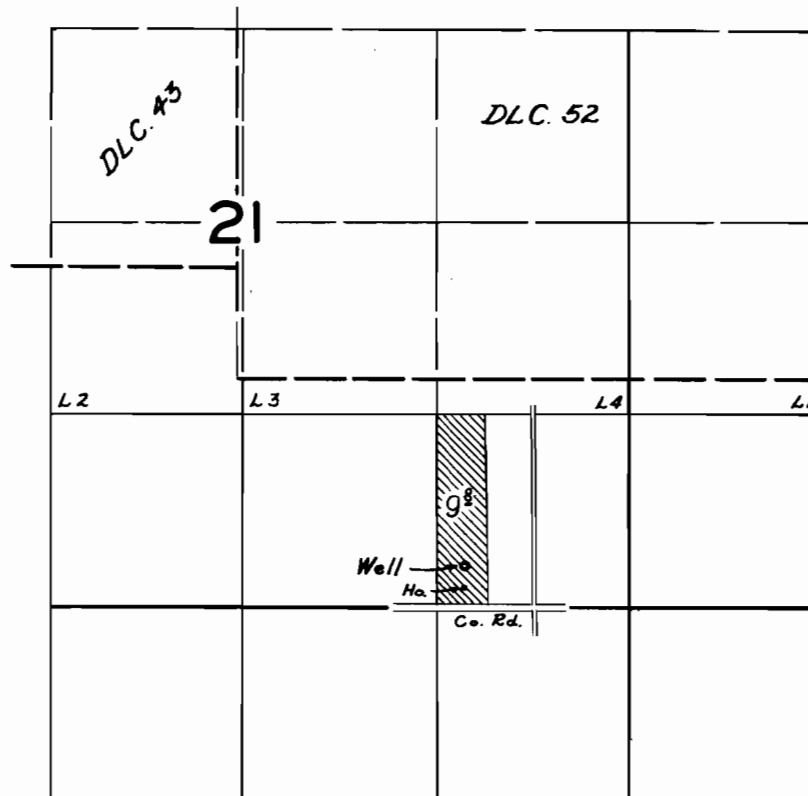

FINAL PROOF SURVEY

UNDER

Application No. G-579 Permit No. G-494

IN NAME OF

Doyle G. Satter

Surveyed Aug. 31 1959, by C. O. Bartels