


T. 7S. R. 2W WM.

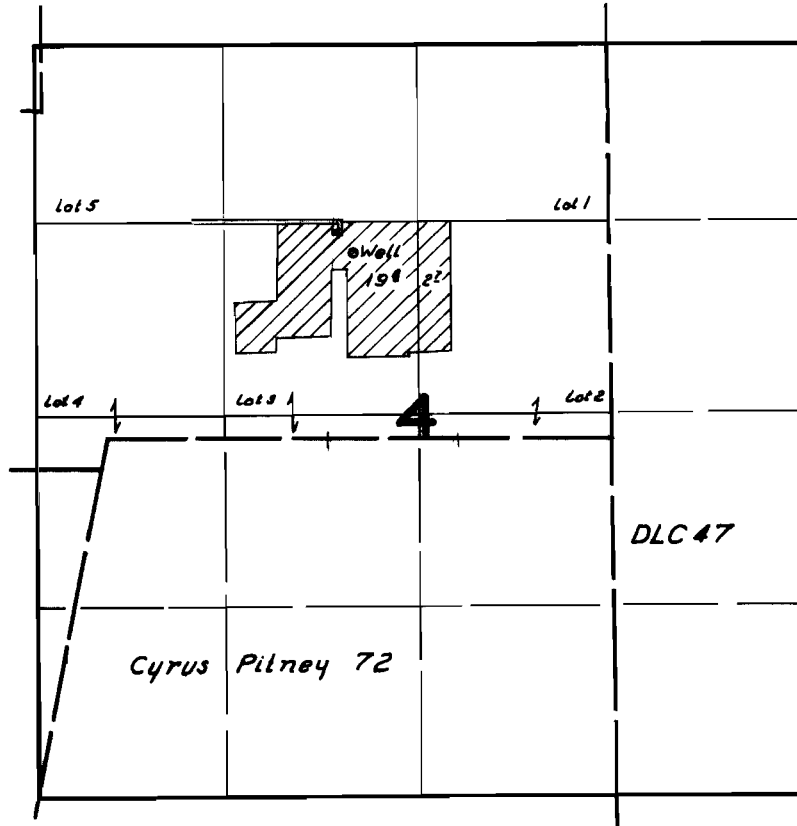

FINAL PROOF SURVEY UNDER

Application No. *G 708* Permit No. *G 617*
IN NAME OF

Peter W. Waelke

Surveyed *July 6* 1959, by *C. O. Bartels*