


T.10S. R.2W.W.M.

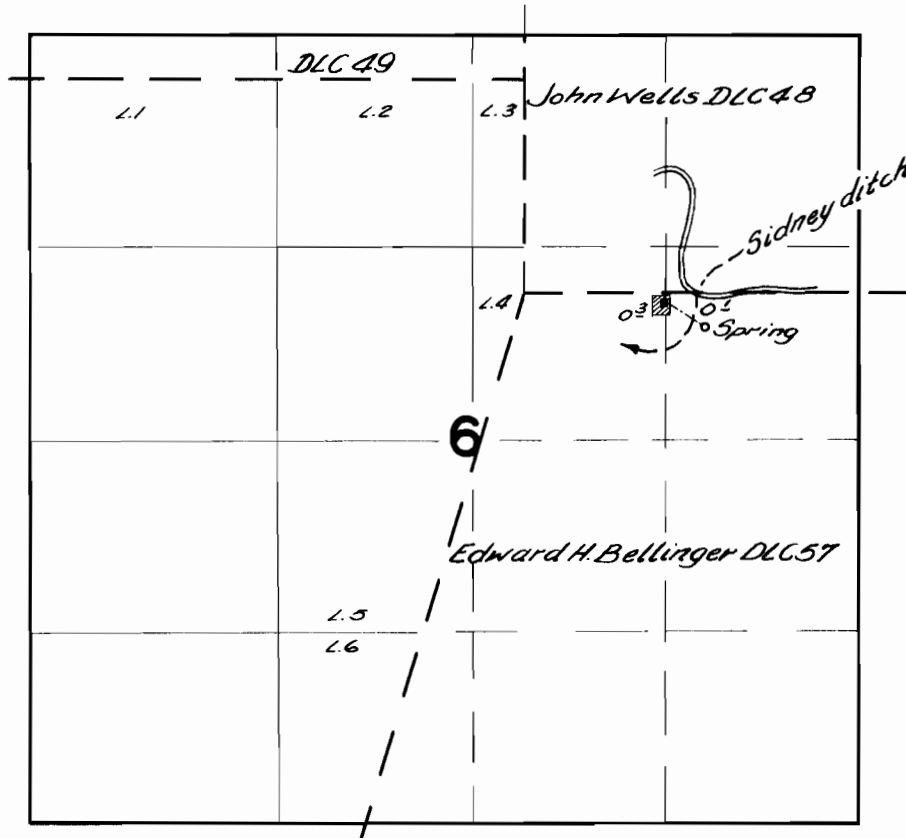

FINAL PROOF SURVEY UNDER

Application No. 18048 Permit No. 13716
IN NAME OF

Earl Ferrier

Surveyed July 27, 1943, by G. V. Naderman