


T. 3S. R. 2W. W. M.

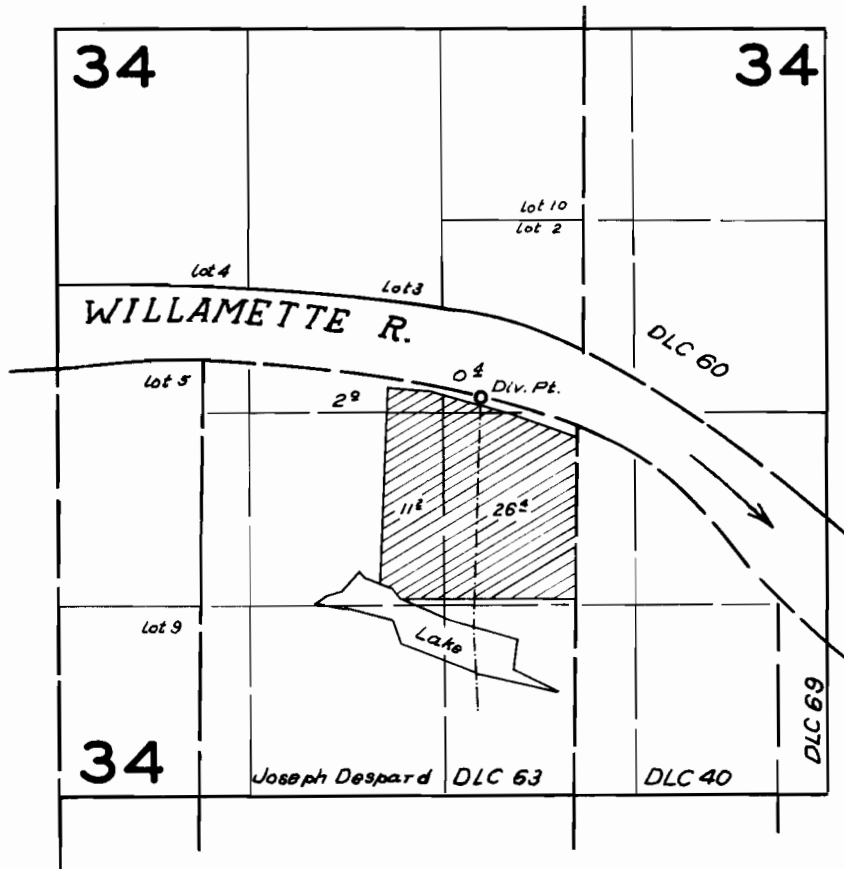

FINAL PROOF SURVEY
UNDER

Application No. 20292... Permit No. 15830.....
IN NAME OF

Henry Abderholden

Surveyed April 20 19.59. by R. H. Jackson.