


T.7S. R.1E.W.M.

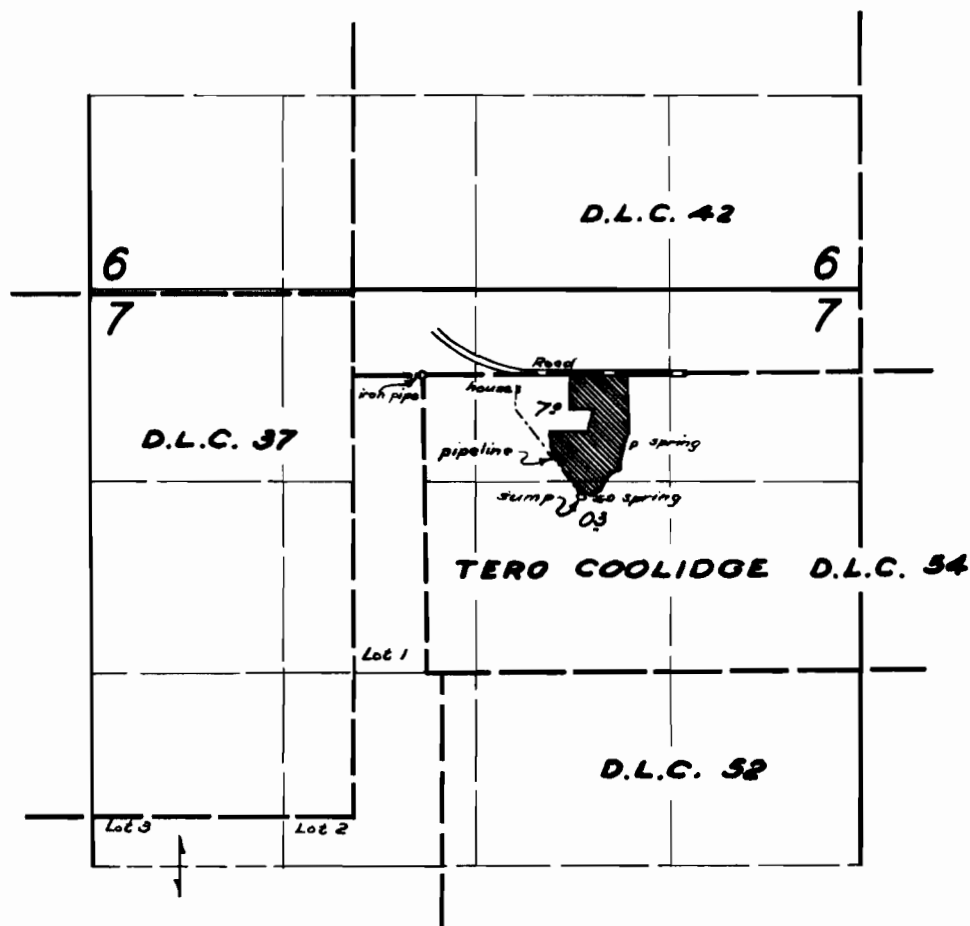

**FINAL PROOF SURVEY**  
UNDER

Application No. 28495 Permit No. 22499  
IN NAME OF

HILMAN J. LOVLIN

Surveyed 28 July 1958, by M. Bish

*[Signature]*