


T. 5&6S. R. 3W. W.M.

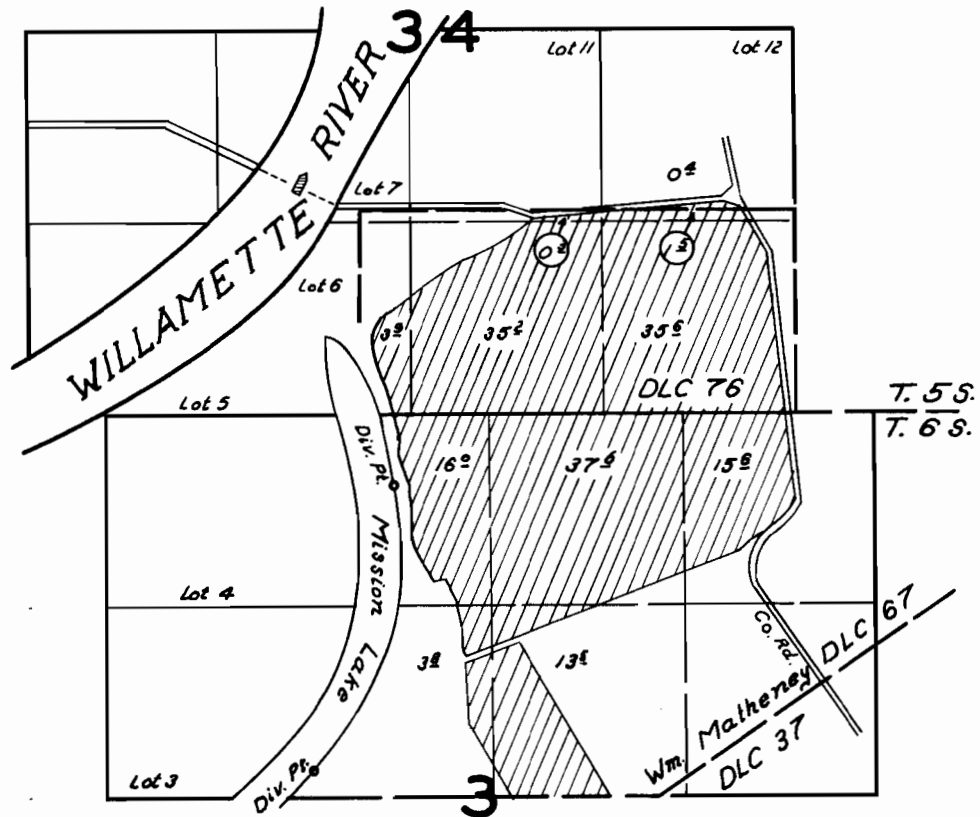

FINAL PROOF SURVEY
UNDER

Application No. 29763 Permit No. 23440
IN NAME OF

Beryl H. LaFollette LaMar

Surveyed May 26 1959, by C.O. Bartels