


T. 4S. R. 1W. W.M.

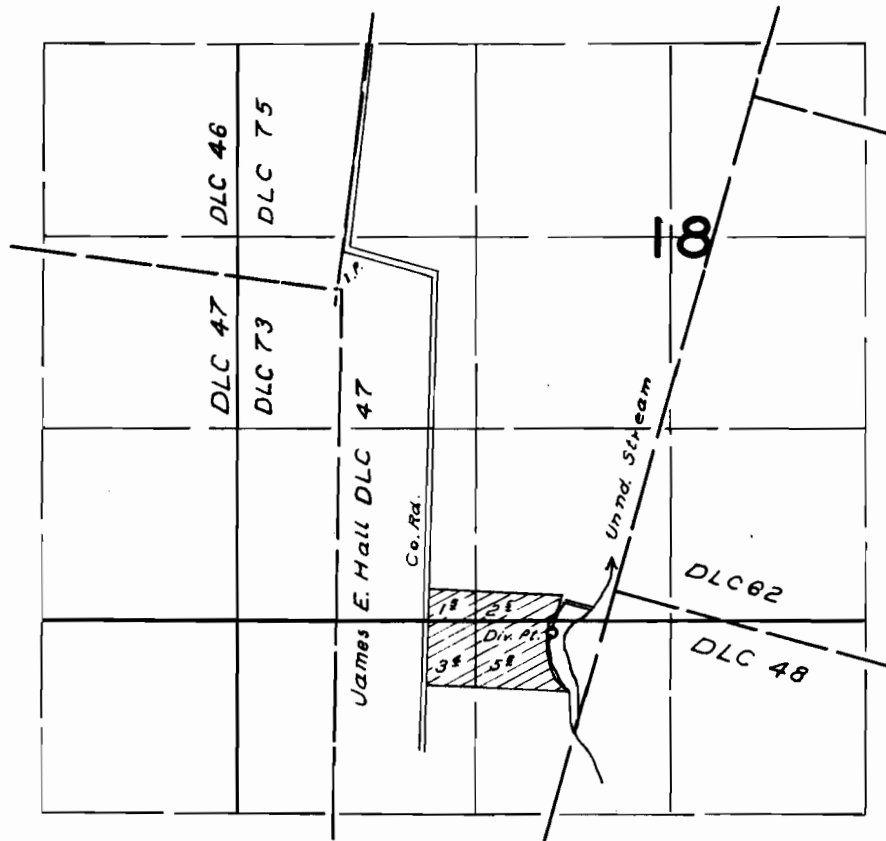

FINAL PROOF SURVEY UNDER

R-29582 R-1812
Application No. 29583 Permit No. 23936
IN NAME OF

Carl Gianella

Surveyed April 22 1959, by *R. H. Jackson*.