


# T. 4S. R. 1W. W.M.

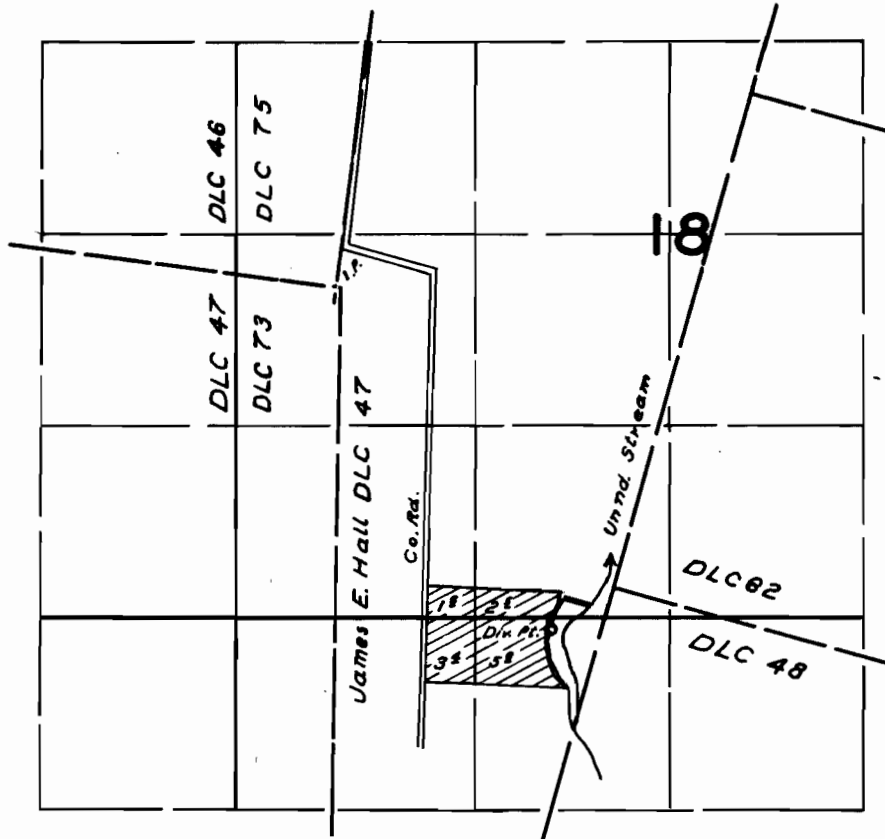

## FINAL PROOF SURVEY UNDER

R-29582 R-1812  
Application No. 29583 Permit No. 23936  
IN NAME OF

.....Carl Gianella.....

Surveyed April 22 1959, by R.H. Jackson.