




# T. 5S. R. 1W. W.M.

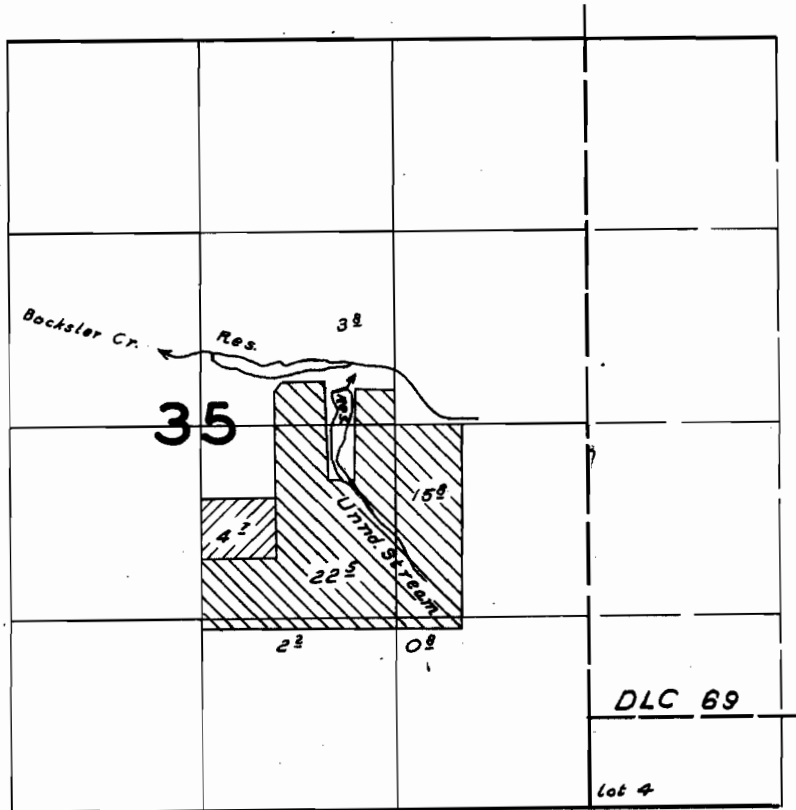

## FINAL PROOF SURVEY UNDER

*Bocksler Cr. Res.*  *Unnd. Str. Res.* 

R31547

R2018

Application No. 31548 Permit No. 24899-  
IN NAME OF

*Edward J. Zach*

Surveyed May 21, 1959, by *R.H. Jackson*