


T. 10S. R. 2W.W.M.

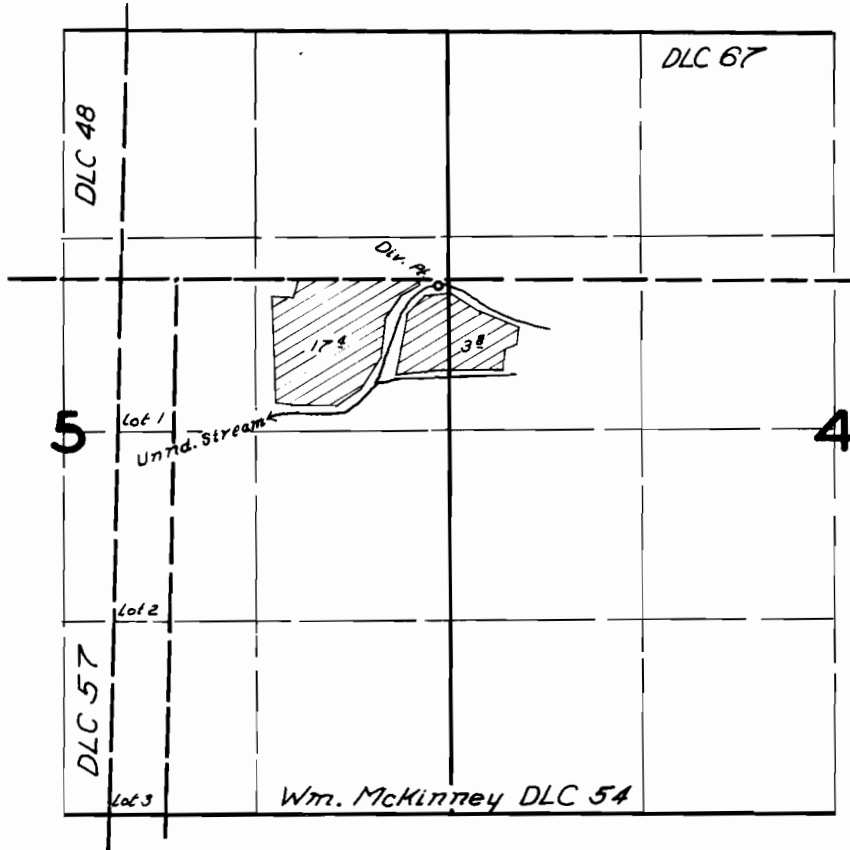

FINAL PROOF SURVEY
UNDER

Application No. 32140 Permit No. 25353
IN NAME OF

Leroy & Leroy McGill dba McGill Bros.

Surveyed April 29 1959, by C. O. Bartels