


T. 9 S. R. 2 W. W.M.

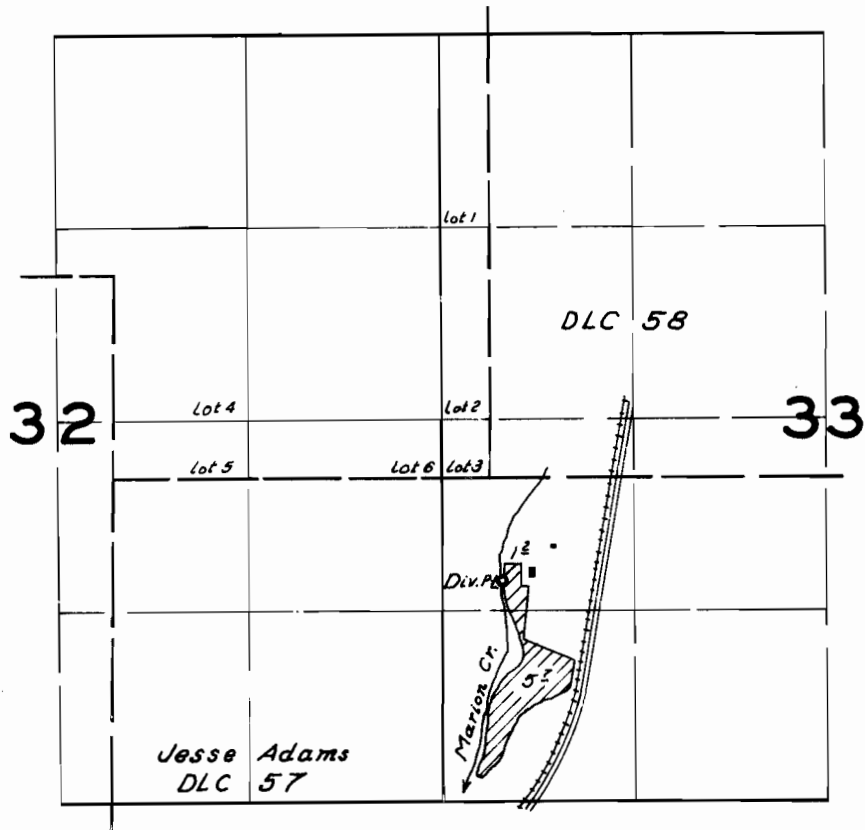

FINAL PROOF SURVEY
UNDER

Application No. 32291... Permit No. 25462...
IN NAME OF

..... *Christina A. Wells*

Surveyed *June 9* 1959, by *C.O. Bartels*...