


T. 8S. R. 6W. W.M.

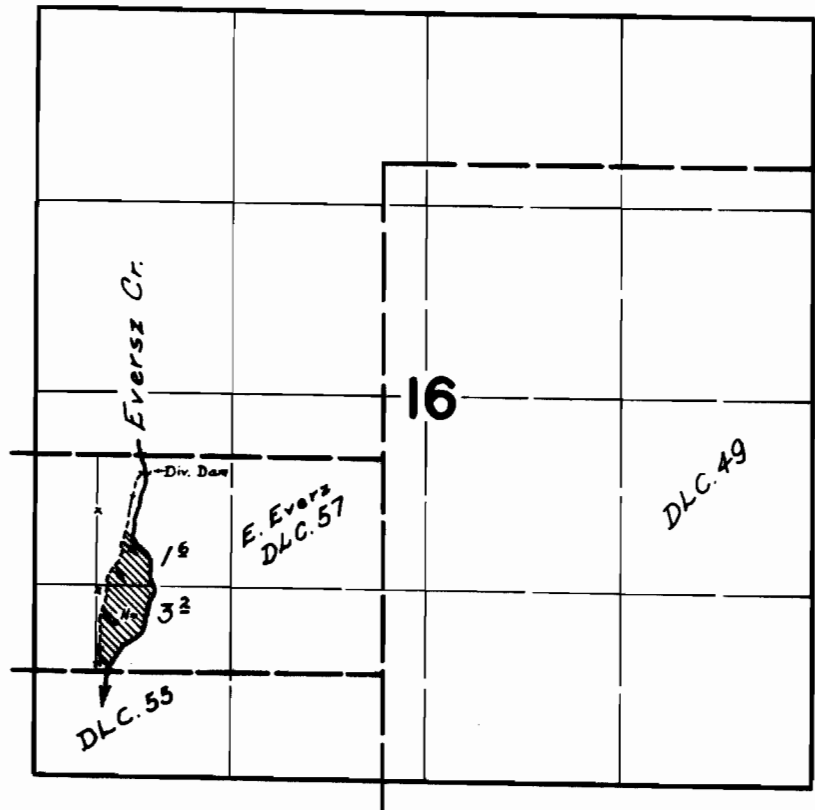

FINAL PROOF SURVEY
UNDER

Application No. 25982 Permit No. 21659
IN NAME OF

Florence F. Rhoades

Surveyed Nov. 7 1958, by C. O. Bartels