


T. 3S. R. 9W. W.M.

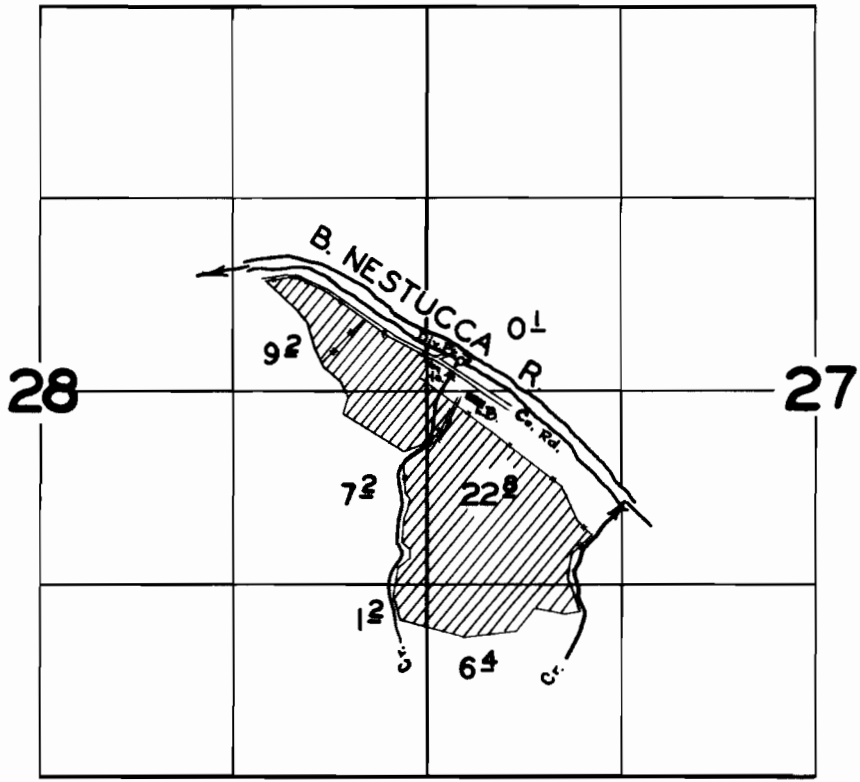

**FINAL PROOF SURVEY**  
UNDER

Application No. 26856 Permit No. 21091  
IN NAME OF

WILLARD R. SORENSEN

Surveyed APR 16 1959, by M. BISH