


T. 4S. R. 9&10W.W.M.

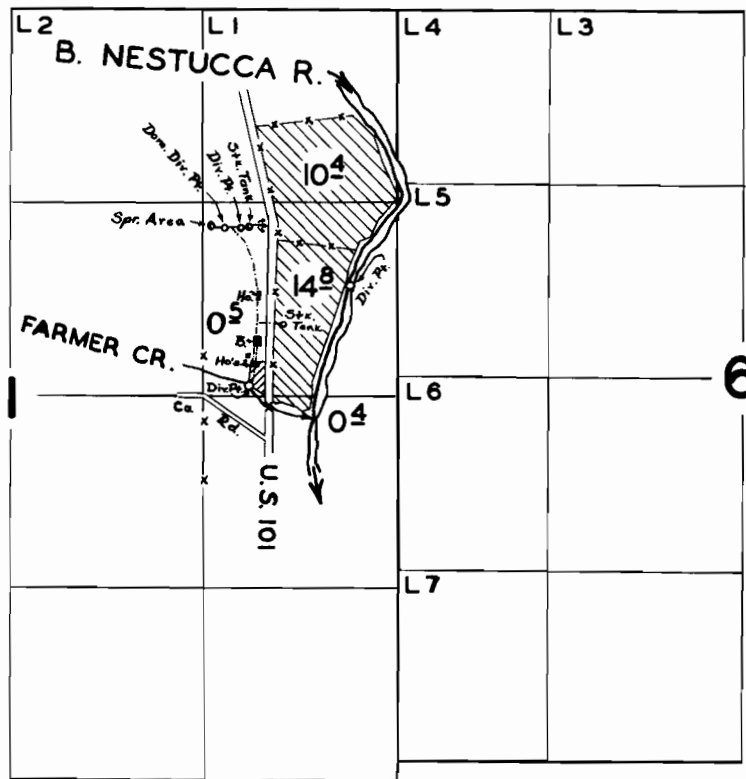

FINAL PROOF SURVEY UNDER

Application No. 29009 Permit No. 22828
IN NAME OF

MAURICE BRASSFIELD

Surveyed APR. 21 1959, by M. BISH