


T. 3S. R. 10W. W.M.

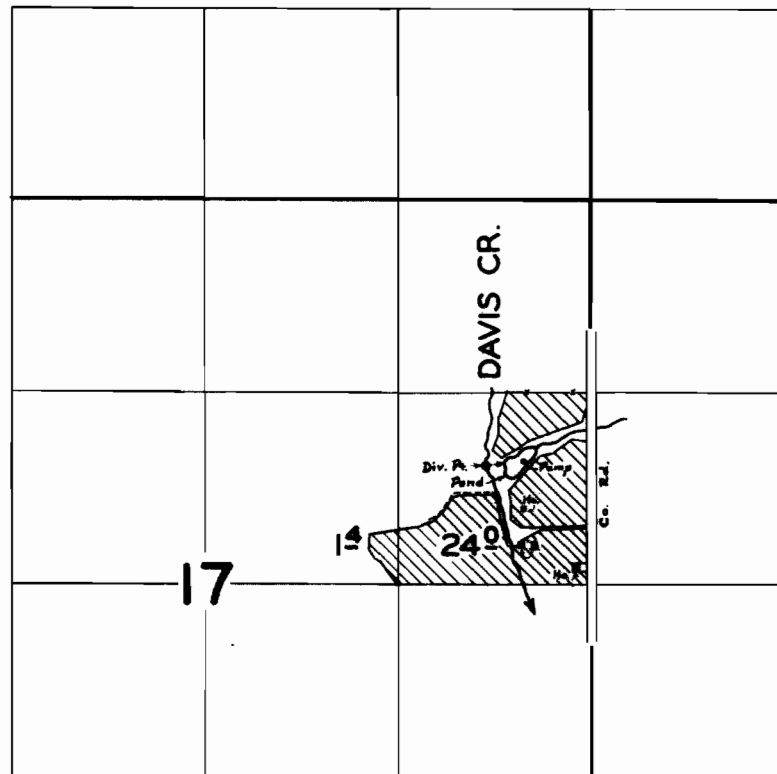

FINAL PROOF SURVEY
UNDER

Application No. 29548 Permit No. 23281
IN NAME OF

JAMES A. WARD

Surveyed APR. 23 1959, by M. BISH