


T. 3S. R. 10W. W.M.

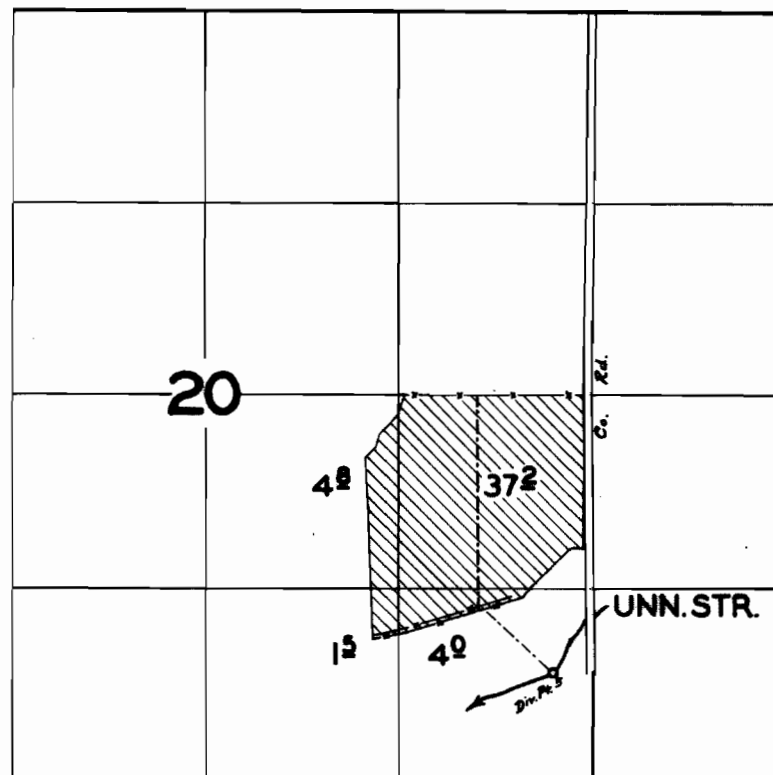

FINAL PROOF SURVEY
UNDER

Application No. 29577. Permit No. 23293
IN NAME OF

JOE O. CHATELAIN

Surveyed APR. 24, 1959, by M. BISH