


T. 3S. R. 9W. W.M.

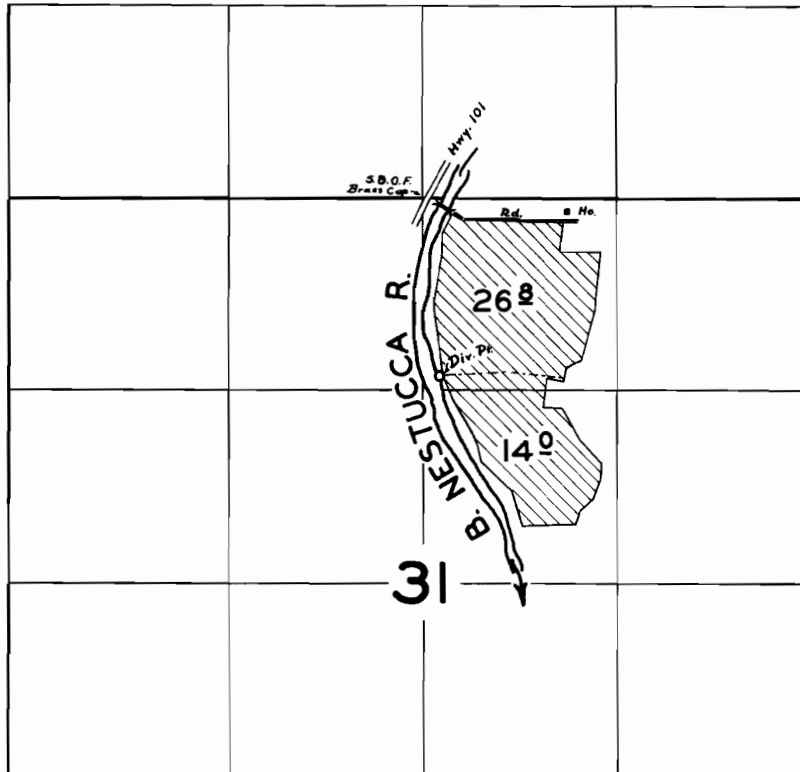

FINAL PROOF SURVEY
UNDER

Application No. 30029 Permit No. 23650
IN NAME OF

CHARLES HODGDON

Surveyed APR. 16 1959, by M. BISH