


T. 3S. R. 10W. W.M.

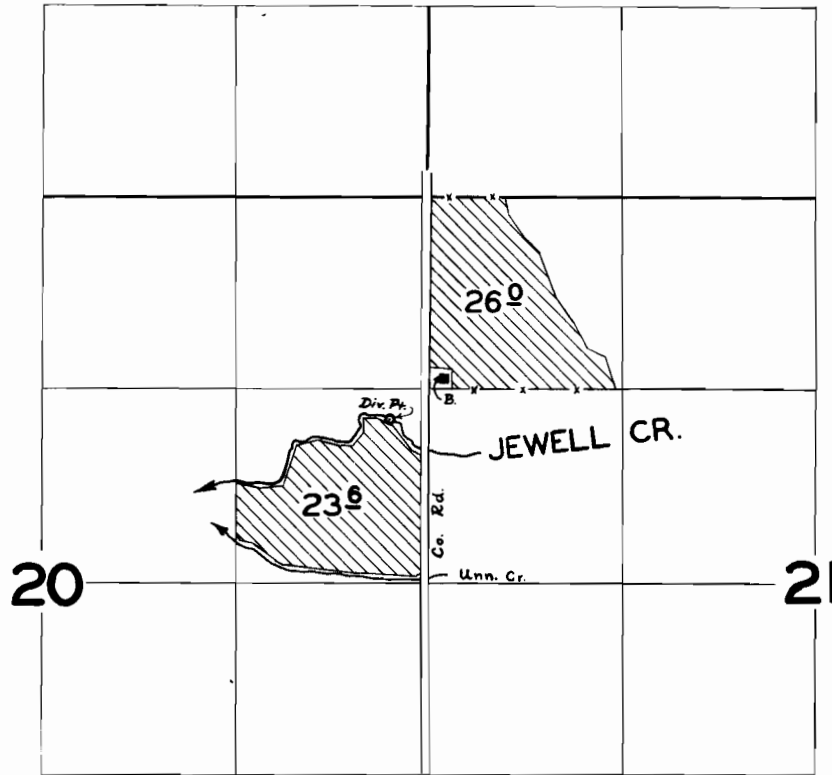

**FINAL PROOF SURVEY**  
UNDER

Application No. 30300 Permit No. 23857  
IN NAME OF

**JESSE SHORTLIDGE**

Surveyed APR. 23 1959, by M. BISH