


T. 3 S. R. 40 E. W. M.

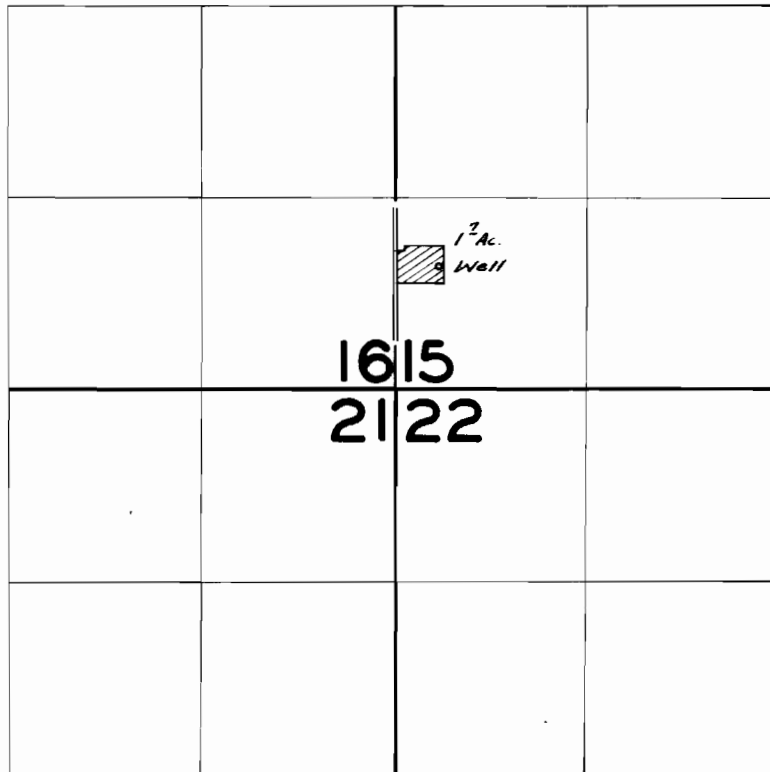

FINAL PROOF SURVEY
UNDER

Application No. *G-1124* Permit No. *G-1098*
IN NAME OF

..... *P.C. Curtis*

Surveyed *Aug. 6* 1959, by *C.Q. Bartels*