


# T.6 S.R.13 & 14 E.W.M.

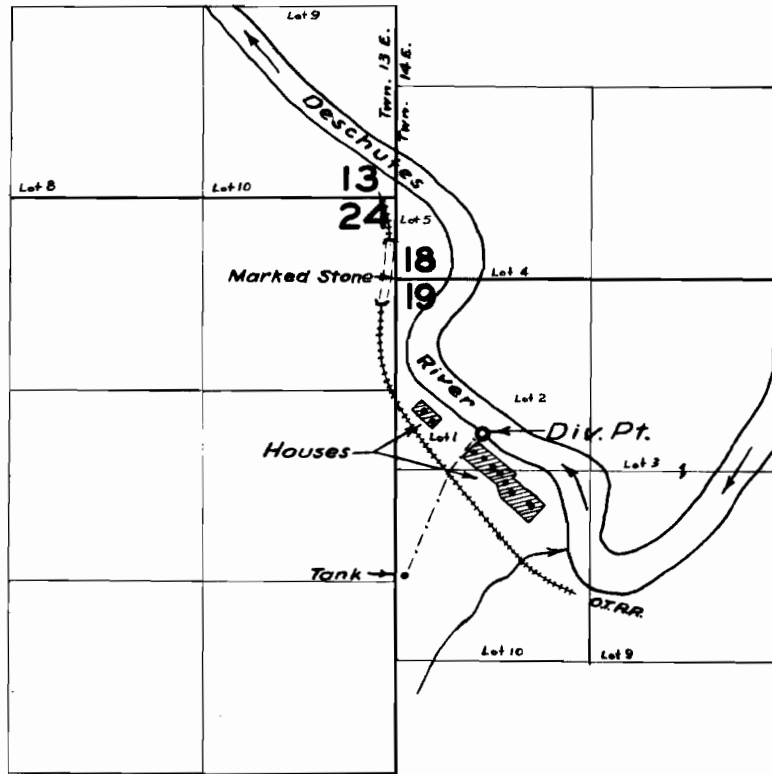

## FINAL PROOF SURVEY UNDER

Application No. 21741 Permit No. 17109  
IN NAME OF

DESCHUTES HOME OWNERS ASSOC.

Surveyed 14 Nov. 1959, by M. Bish