


T. IN.&IS. R. 4W.W.M.

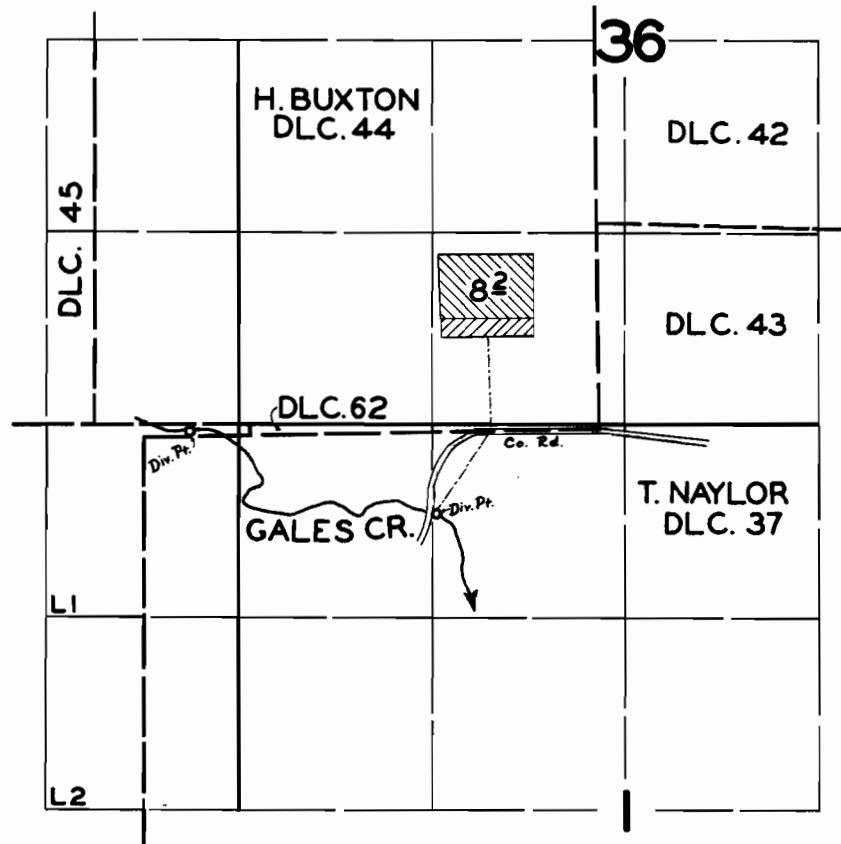

**FINAL PROOF SURVEY**  
UNDER

Application No. 25555 Permit No. 20067  
IN NAME OF

FOREST VIEW CEMETERY

Surveyed JUNE 1, 1959, by M. BISH