


T. IN. R. 4W. W.M.

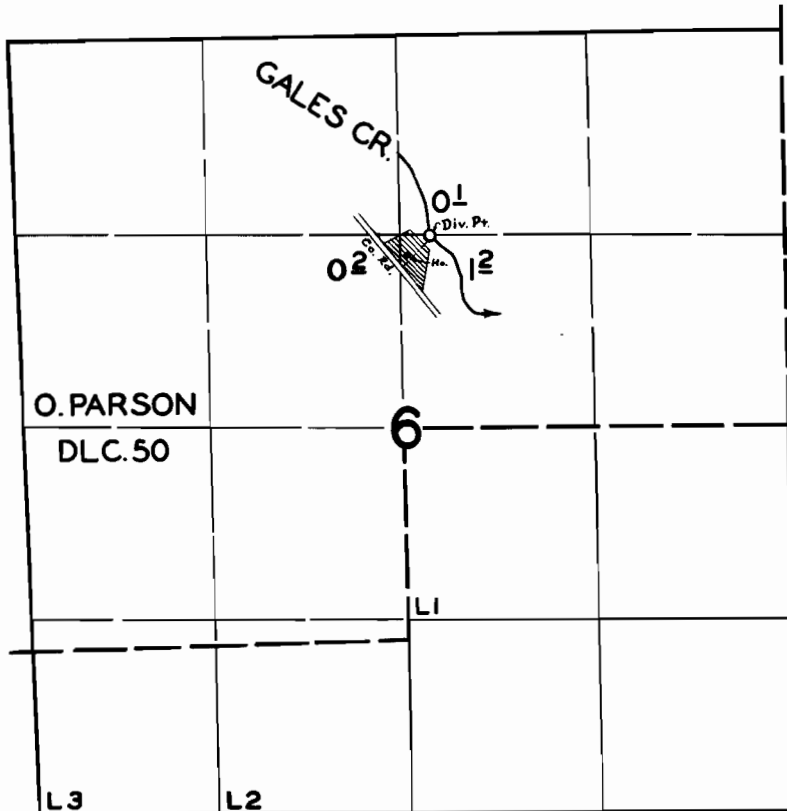

FINAL PROOF SURVEY
UNDER

Application No. 30739 Permit No. 24220
IN NAME OF

BILL I. SCHOFIELD

Surveyed JUNE 5 1959 by M. BISH