


T. IN. R. 4W.W.M.

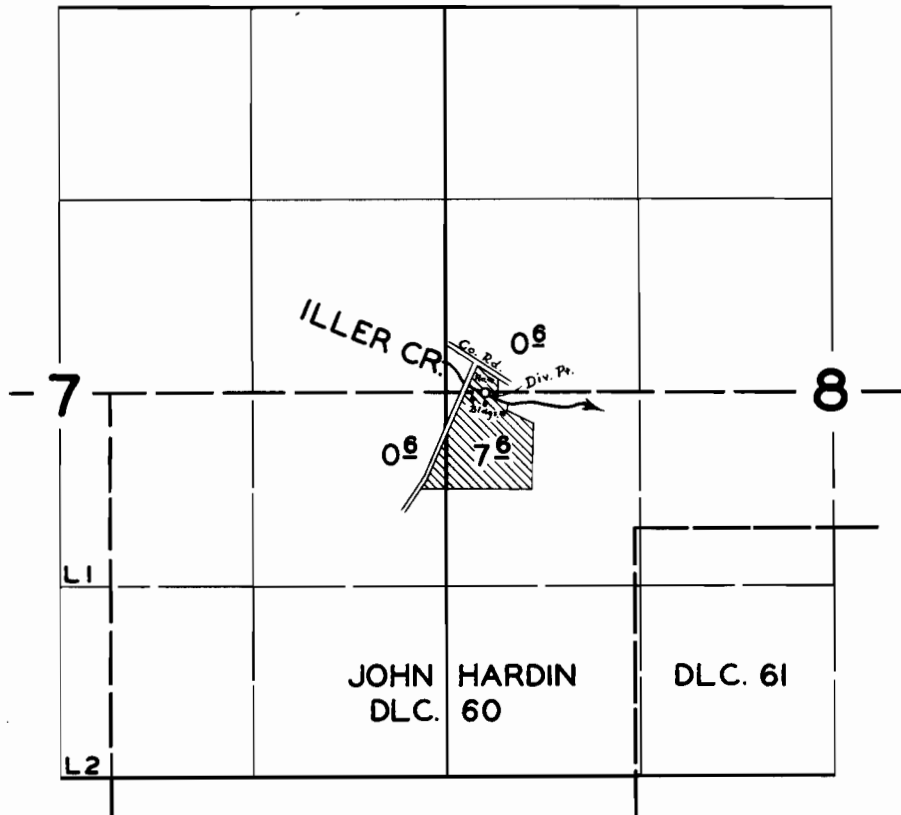

FINAL PROOF SURVEY
UNDER

Application No. 30955 Permit No. 24351
IN NAME OF

SAMUEL A. SHORB

Surveyed JUNE 5 1959, by M. BISH