


T. 2N. R. 4W. W.M.

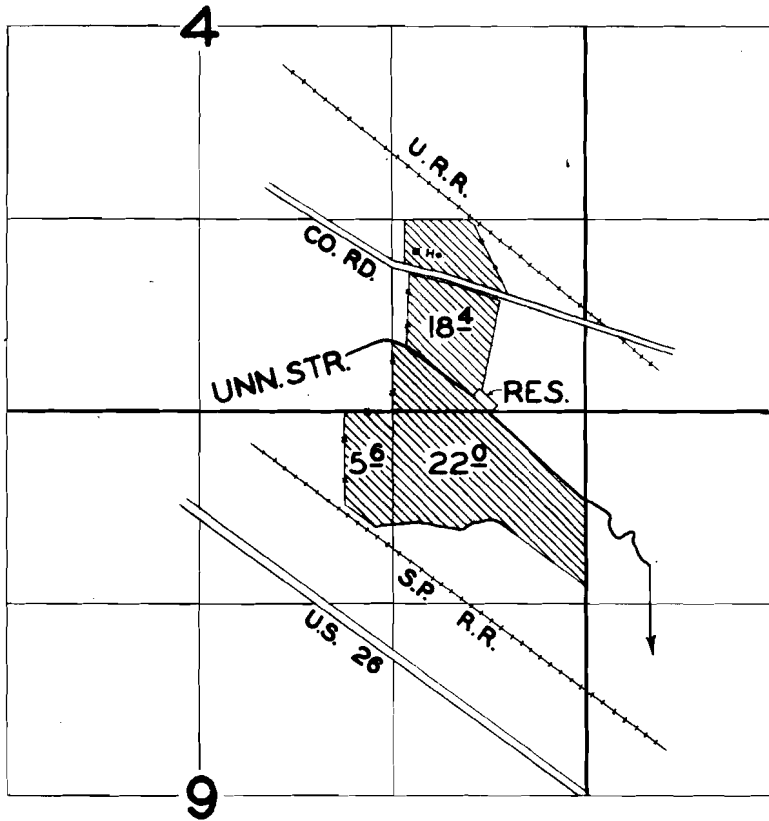

**FINAL PROOF SURVEY**  
UNDER

R-31336 R-1983  
Application No. 31337 Permit No. 24695  
IN NAME OF

**MYRON HEESACKER**

Surveyed JUNE 3, 1959, by M. BISH