


T. 2N. R. 4W. W.M.

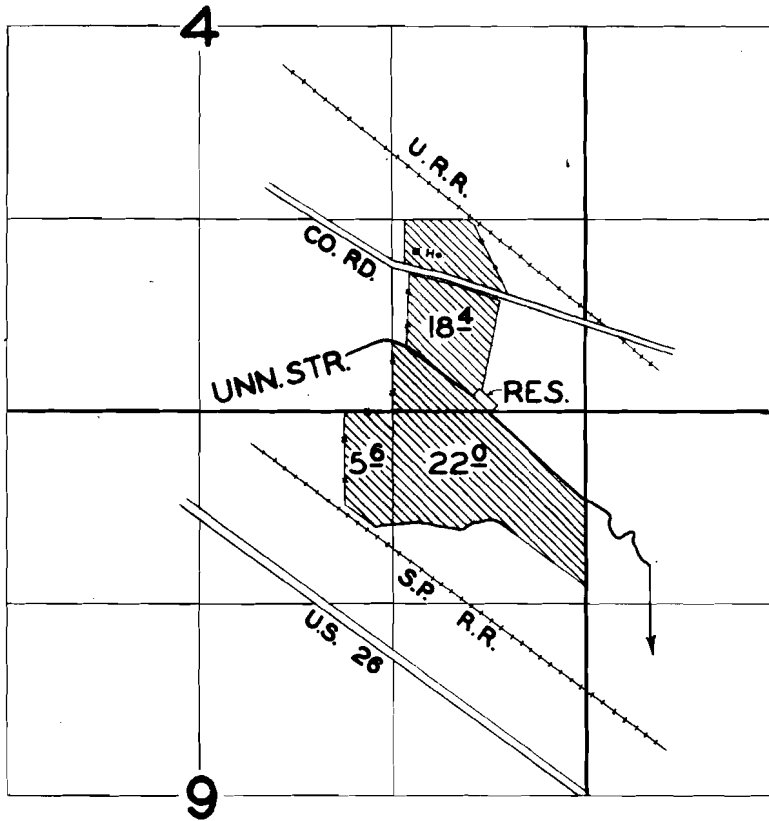

FINAL PROOF SURVEY
UNDER

R-31336 R-1983
Application No. 31337 Permit No. 24695
IN NAME OF

MYRON HEESACKER

Surveyed JUNE 3, 1959, by M. BISH