


# T. IS. R. 4W.W.M.

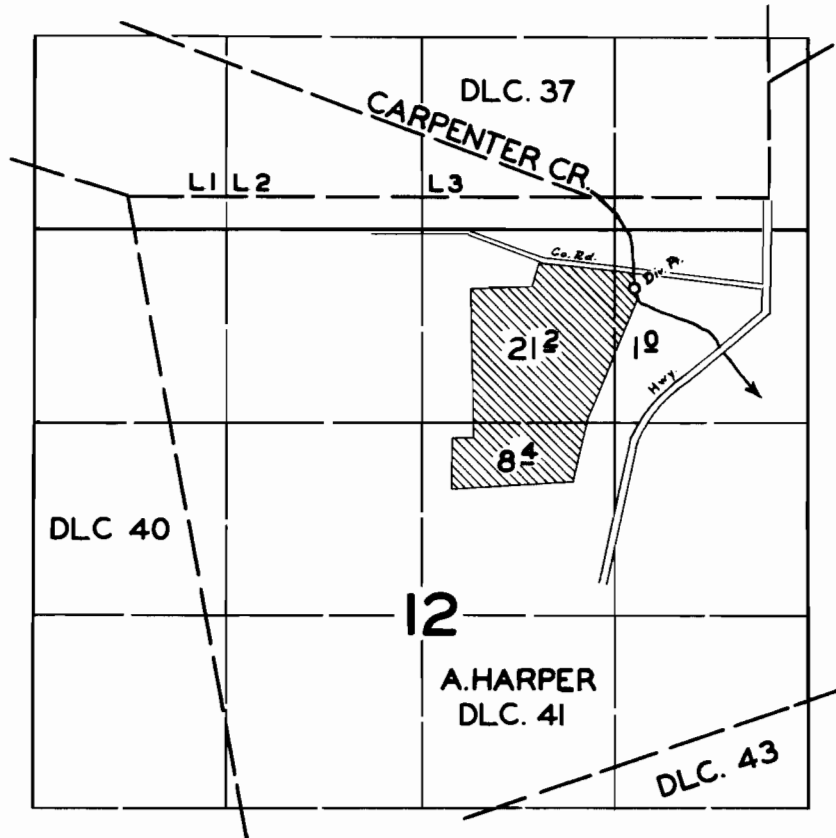

## FINAL PROOF SURVEY UNDER

Application No. 26122 Permit No. 24877  
IN NAME OF

GLEN H. EPLER

Surveyed JUNE 2 1959, by M. BISH