


T. 2N. R. 4W. W.M.

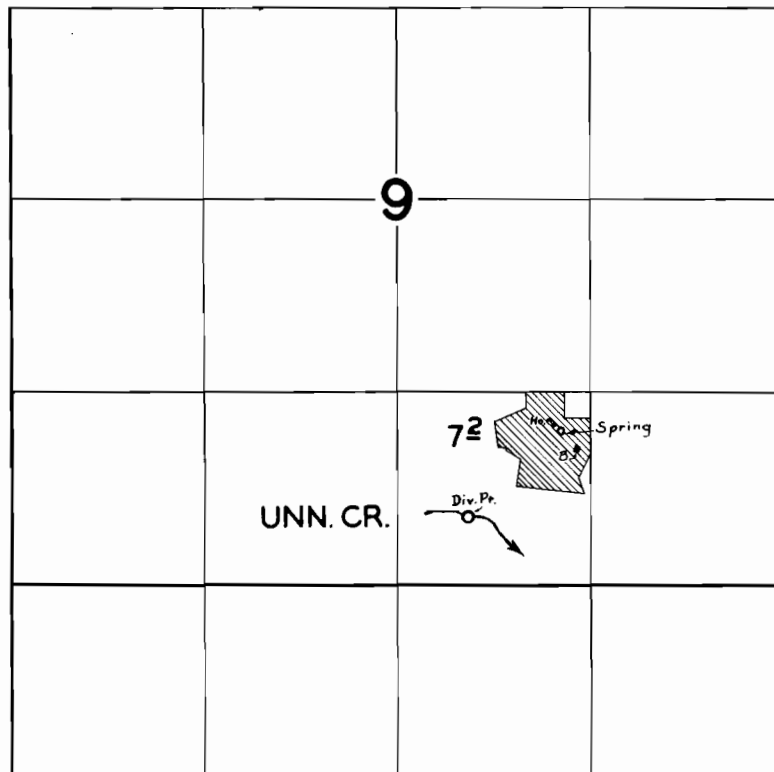

FINAL PROOF SURVEY
UNDER

Application No. 25330 32449 Permit No. 19873 25626
IN NAME OF

ERICH PORSHMAN

Surveyed JUNE 3 1959, by M. BISH