


T. 4S. R. 4W.W.M.

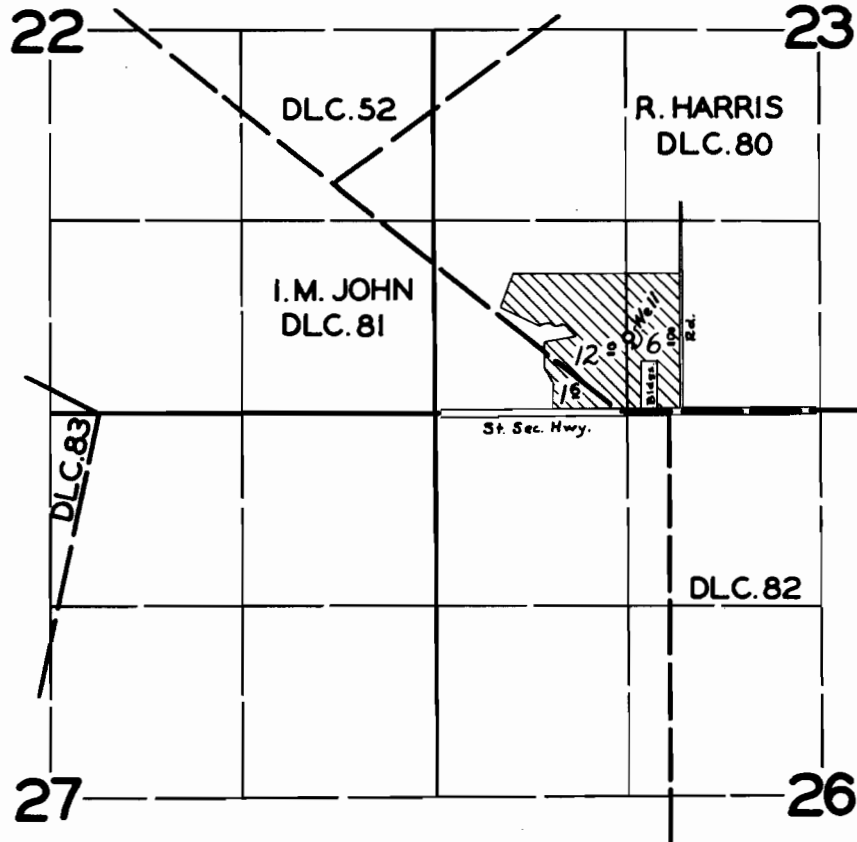

FINAL PROOF SURVEY

UNDER

Application No. G-255 Permit No. G-166

IN NAME OF

S. L. BAKER

Surveyed SEPT. 8 19 59, by M. BISH