


T.5-6S.R.5W.W.M.

COPY  
Consistent w/  
Cert. 27911

Total Acres =  
142.1 AC

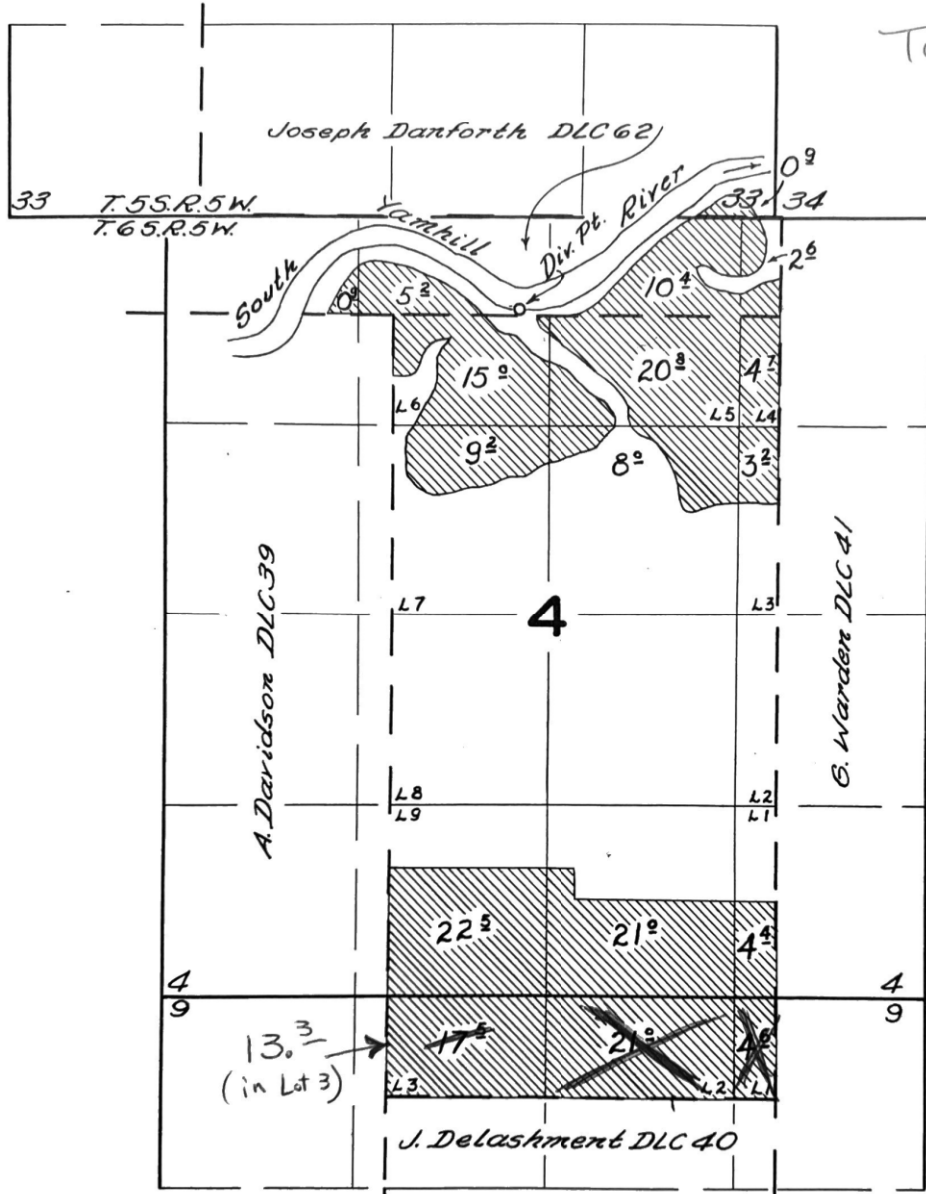

T.6s R.5W  
Section 9  
Lot 1 = 0.0 AC  
Lot 2 = 0.0 AC  
Lot 3 = 13.3 AC

**FINAL PROOF SURVEY**  
UNDER

Application No. 27819... Permit No. 22426..  
IN NAME OF

.....*Robert E. Scharf*.....

Surveyed *May 3*, 1958, by *M. Bish*.....