


T. 3S. R. 2W. WM.

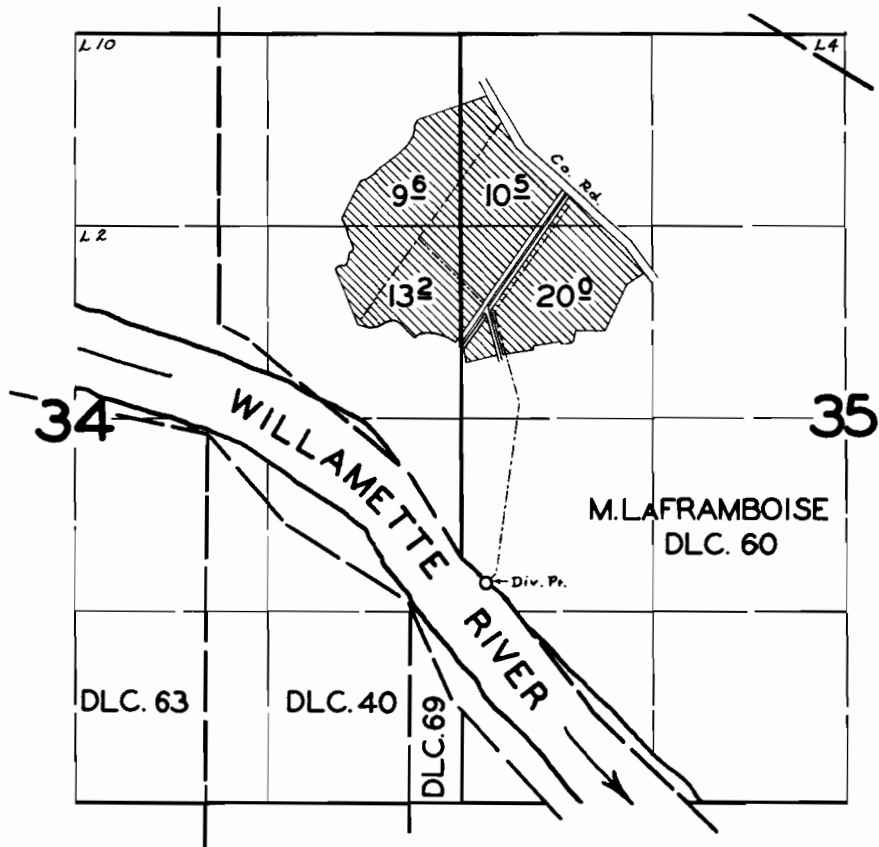

FINAL PROOF SURVEY

UNDER

Application No. 29883 Permit No. 23474

IN NAME OF

FRED W. WICKMAN

Surveyed SEPT. 9 1959, by M. BISH