


T. 2S. R. 3W. W.M.

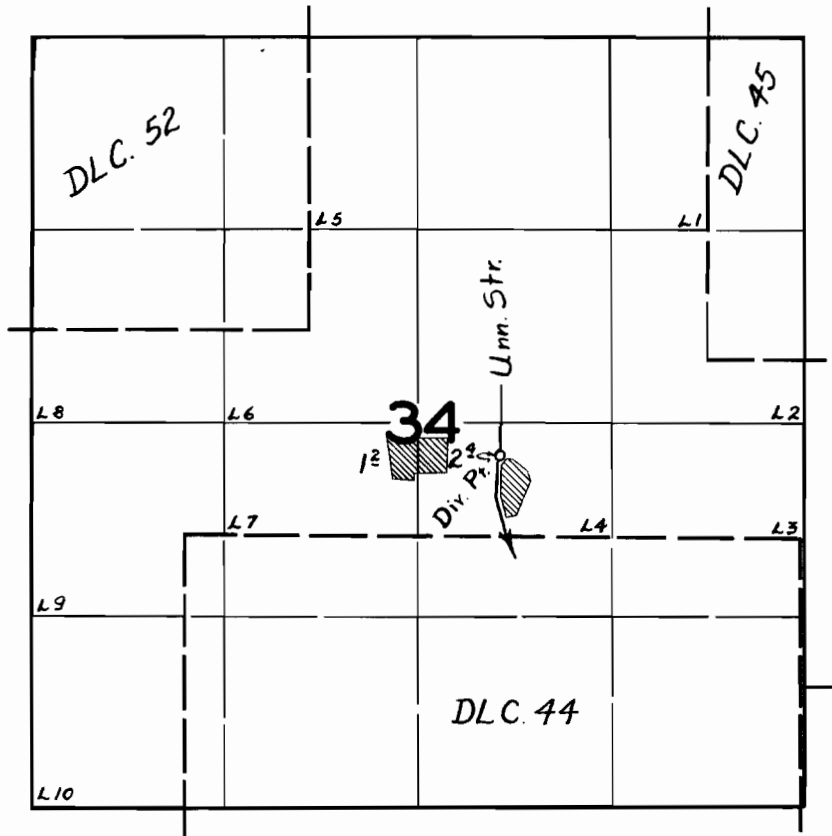

FINAL PROOF SURVEY
UNDER
Section No. 30287 Range No. 23727
IN NAME OF
THEODORE R. BURNS
Surveyed Sept 8 1959, by M. Bish