


T. 3S. R. 3W. W.M.

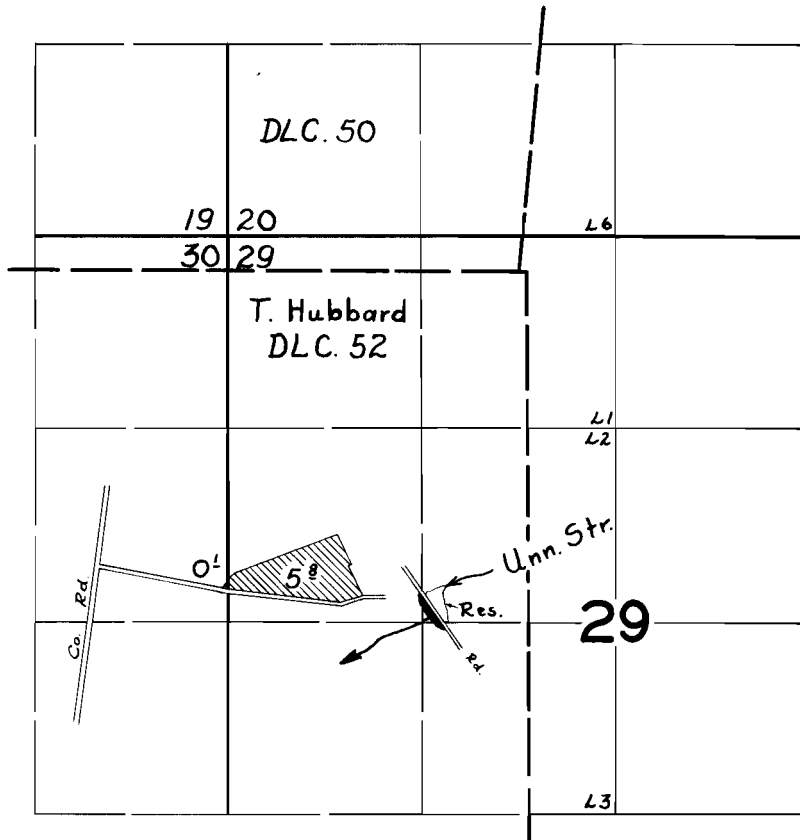

FINAL PROOF SURVEY

Application No. R-31525 31526 Permit No. R-2013 24864

IN NAME OF

*The Trappist Abbey of our Lady of Guadalupe*

Surveyed Sept. 10 1959 by M. Bish