


T.2S.R.38-39E.W.M.

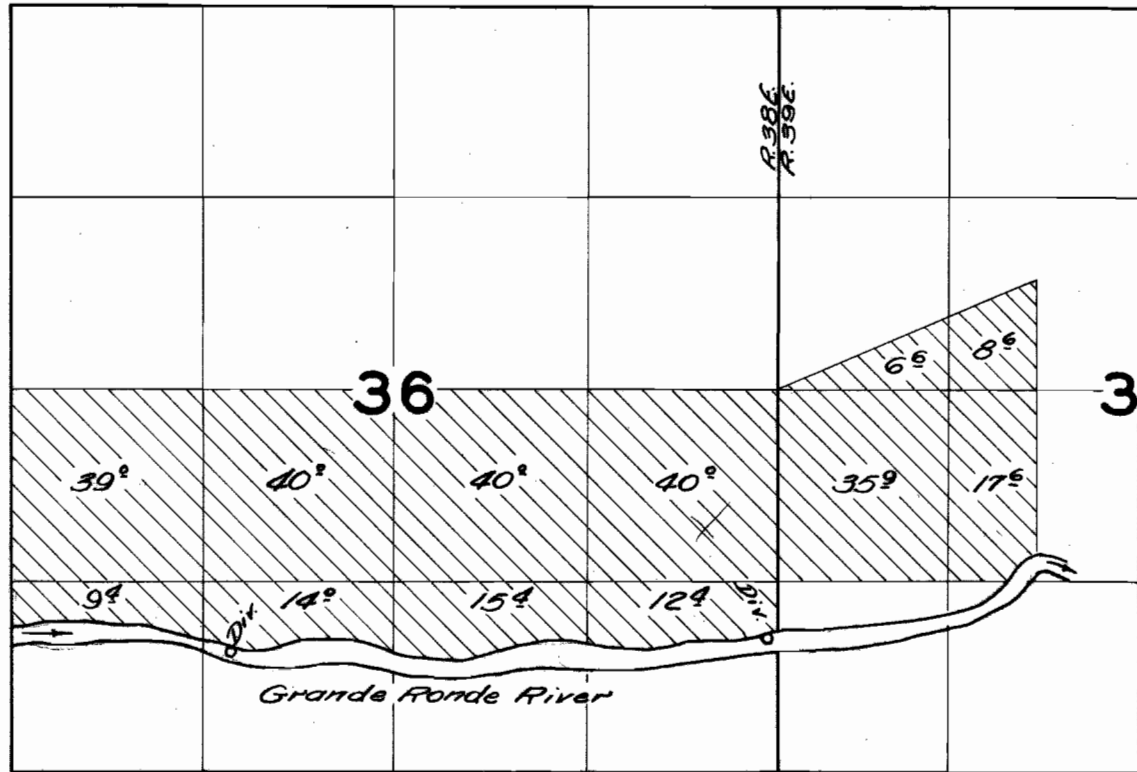

FINAL PROOF SURVEY

UNDER

Application No. 27824 Permit No. 21835

IN NAME OF

Surveyed Aug. 15 1959, by C.O. Baugh