


P-25520

27922
27793

T. 13S. R. 30 & 31E. W.M.

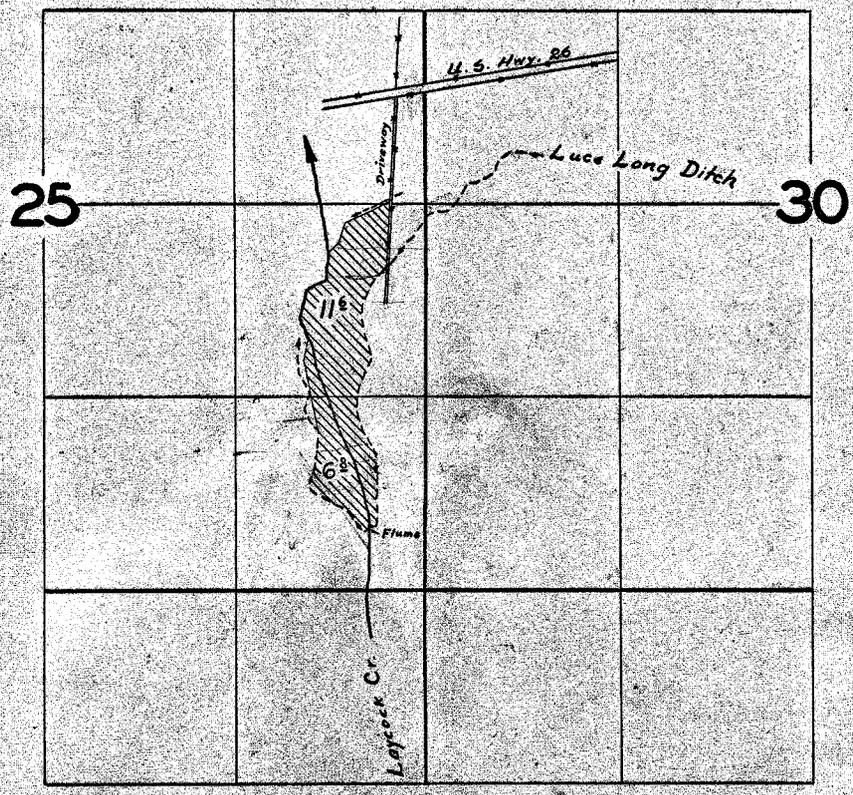

FINAL PROOF SURVEY UNDER

Application No. 32199 Permit No. 25520
IN NAME OF

ANTHONY P. BRAGGA

Surveyed AUG. 7. 1959, by M. BISH